
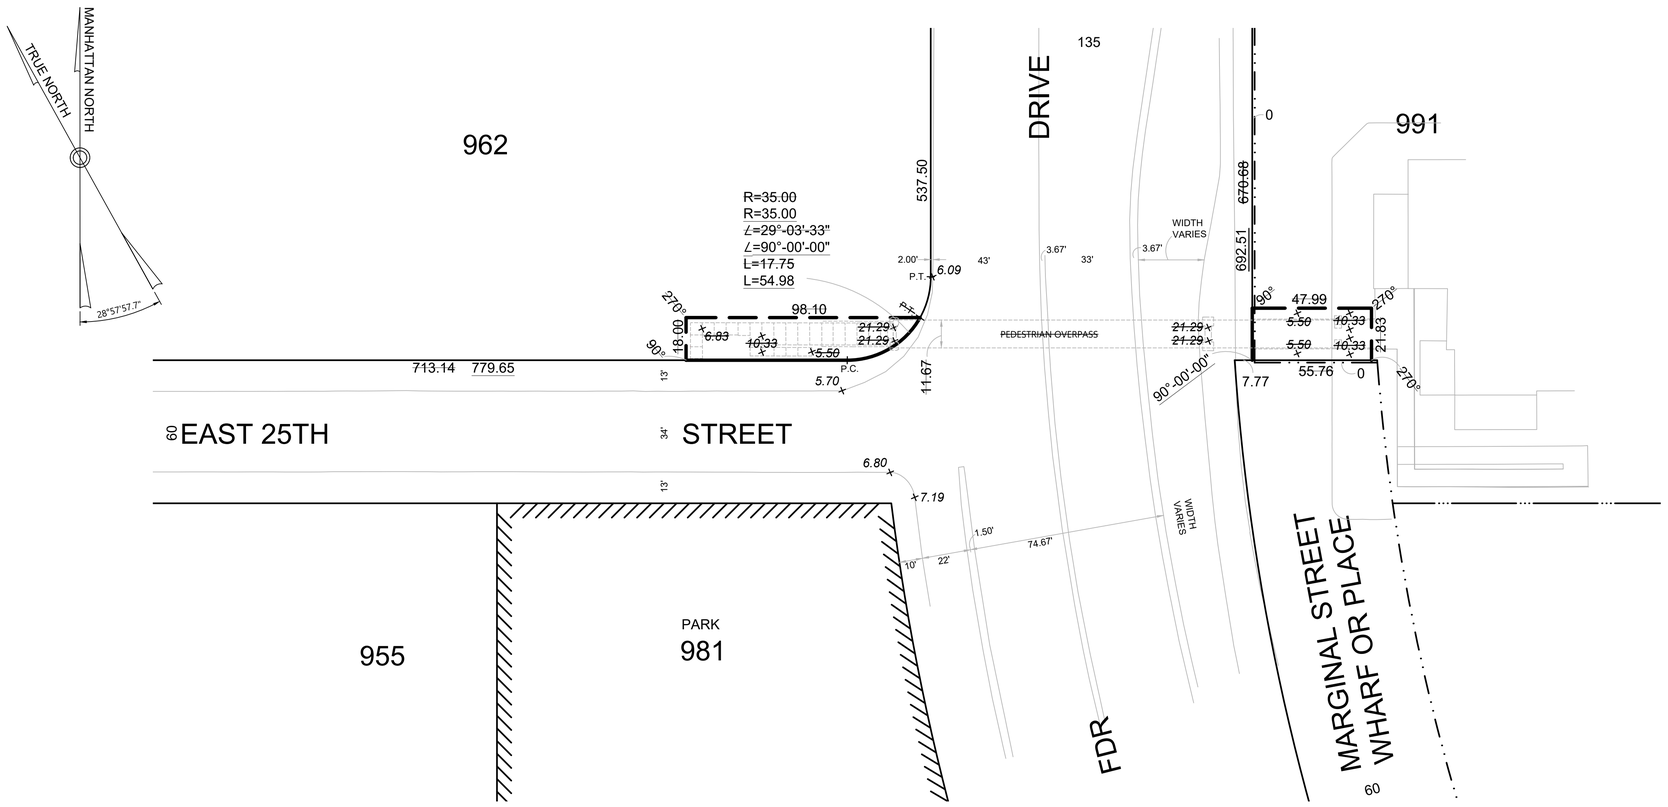


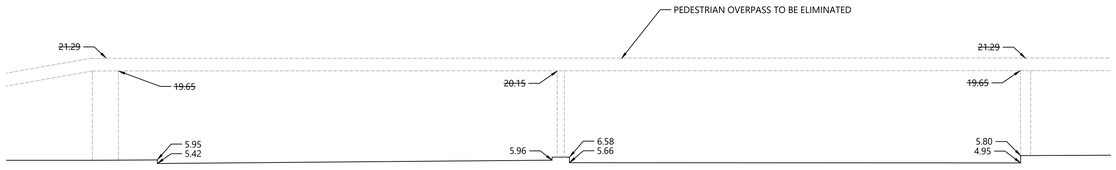

SECTION ACROSS DRIVE

SCALE: 1" = 10'

NOTES

- Indicates street line heretofore established and hereby reconstructed
- Indicates street line heretofore established and hereby eliminated
- Indicates street line heretofore established and hereby retained
- Indicates U.S. bulkhead line
- Indicates U.S. pierhead line
- Indicates treatment line heretofore established and hereby eliminated
- PARK — Indicates park or park addition heretofore established and hereby retained
- 955 — Indicates Manhattan tax block number
- 60 — Indicates roadway dimensions heretofore established and hereby retained
- 67.57 — Indicates dimensions hereby established
- 685.25 — Indicates dimensions heretofore established and hereby retained
- ~~713.14~~ — Indicates dimensions heretofore established and hereby eliminated
- *6.82* — Indicates elevation heretofore established and hereby retained
- ~~*22.94*~~ — Indicates elevation heretofore established and hereby eliminated
- 13' — Indicates roadway and sidewalk treatment heretofore established and hereby retained

CITY OF NEW YORK
BOROUGH OF MANHATTAN
OFFICE OF THE PRESIDENT
TOPOGRAPHICAL BUREAU

MAP ACC. NO. 30272

SHOWING A CHANGE IN THE CITY MAP

BY ELIMINATING
THE LINES AND GRADES OF THE
PEDESTRIAN OVERPASS
OVER FDR DRIVE AT EAST 25TH STREET;
ADJUSTING THE STREET LINES OF
FDR DRIVE AND EAST 25TH STREET
IN THE VICINITY OF THE PEDESTRIAN OVERPASS;
AND ADJUSTING THE GRADES, BLOCK DIMENSIONS
AND ANGLES NECESSITATED HEREBY

No changes are contemplated in blocks shown without dimensions.

Elevations apply to top of curb unless otherwise indicated.

Elevations refer to the HIGHWAY datum of the borough of MANHATTAN, which is 2.07 feet (0.631 meters) above the U.S.C. & G. Mean Sea Level datum at Sandy Hook, New Jersey.

Legal grades whose values remain unchanged, but whose locations (at top of curb) have shifted because sidewalk/treatment lines have been relocated, are shown as being unchanged.

ENGLISH SCALE: 1 INCH = 30 FEET

0 30 60 90 120

0 9.14 18.3 27.4 36.6

METRIC SCALE: 1 CM = 9.14 METERS (30 FEET)

Geometry shown on this drawing has been certified by Jason Larson, PLS, and is based on a survey prepared by VHB on 10 / 2023.

CHECKED BY: _____

REVIEWED BY: _____

APPLICANT

NYCEDC
ONE LIBERTY PLAZA, NEW YORK, NY
TEL: (212) 619-5000

PREPARED BY:

VHB ENGINEERING, SURVEYING, LANDSCAPE
ARCHITECTURE AND GEOLOGY, P.C.
ONE PENN PLAZA, SUITE 715
NEW YORK, NY 10019
TEL: (212) 857-7350

STATE OF NEW YORK — JAMES W. PROUTY — 097619 — LICENSED PROFESSIONAL ENGINEER

REFERENCE MAPS:

B.P. ACC. MAP NO.	(D.C.P. NO.)	DATED
27806		September 25, 1939
28026		August 7, 1940
28141		June 5, 1941
28445		November 23, 1942
28548		October 10, 1944
29320		December 6, 1945
28659		February 6, 1946
28714	CP-7576	June 19, 1946
28990		June 15, 1949
29074		November 24, 1950
29515		March 4, 1958
30239		January 25, 2013

I, _____, Secretary of the City Planning Commission, do hereby certify that this map is one of _____ similar maps approved by the City Planning Commission on the ____ day of _____ (Cal. No. ____), and subsequently approved by the City Council on _____ (Res. _____), which action comprised final approval, and that this map was filed on the date of this certification and will take effect on the following day.

Dated: New York _____

_____
Secretary, City Planning Commission

DATED: _____

_____ P.E.
PRESIDENT - BOROUGH OF MANHATTAN — CONSULTING ENGINEER

© 2024 President Borough of Manhattan

File #xxxxx