


Atlantic Avenue Mixed Use Plan Tax Map Sections Key
1
2
3
4
5
6
7
8
9
10
11
12
R7-2
C6-3X
C6-3A
M1-4A/R9A
M1-3A
C4-3A
C4-5D
M1-1A/R6B
M1-3A/R7D
M1-2A/R6A
R7A
R7D

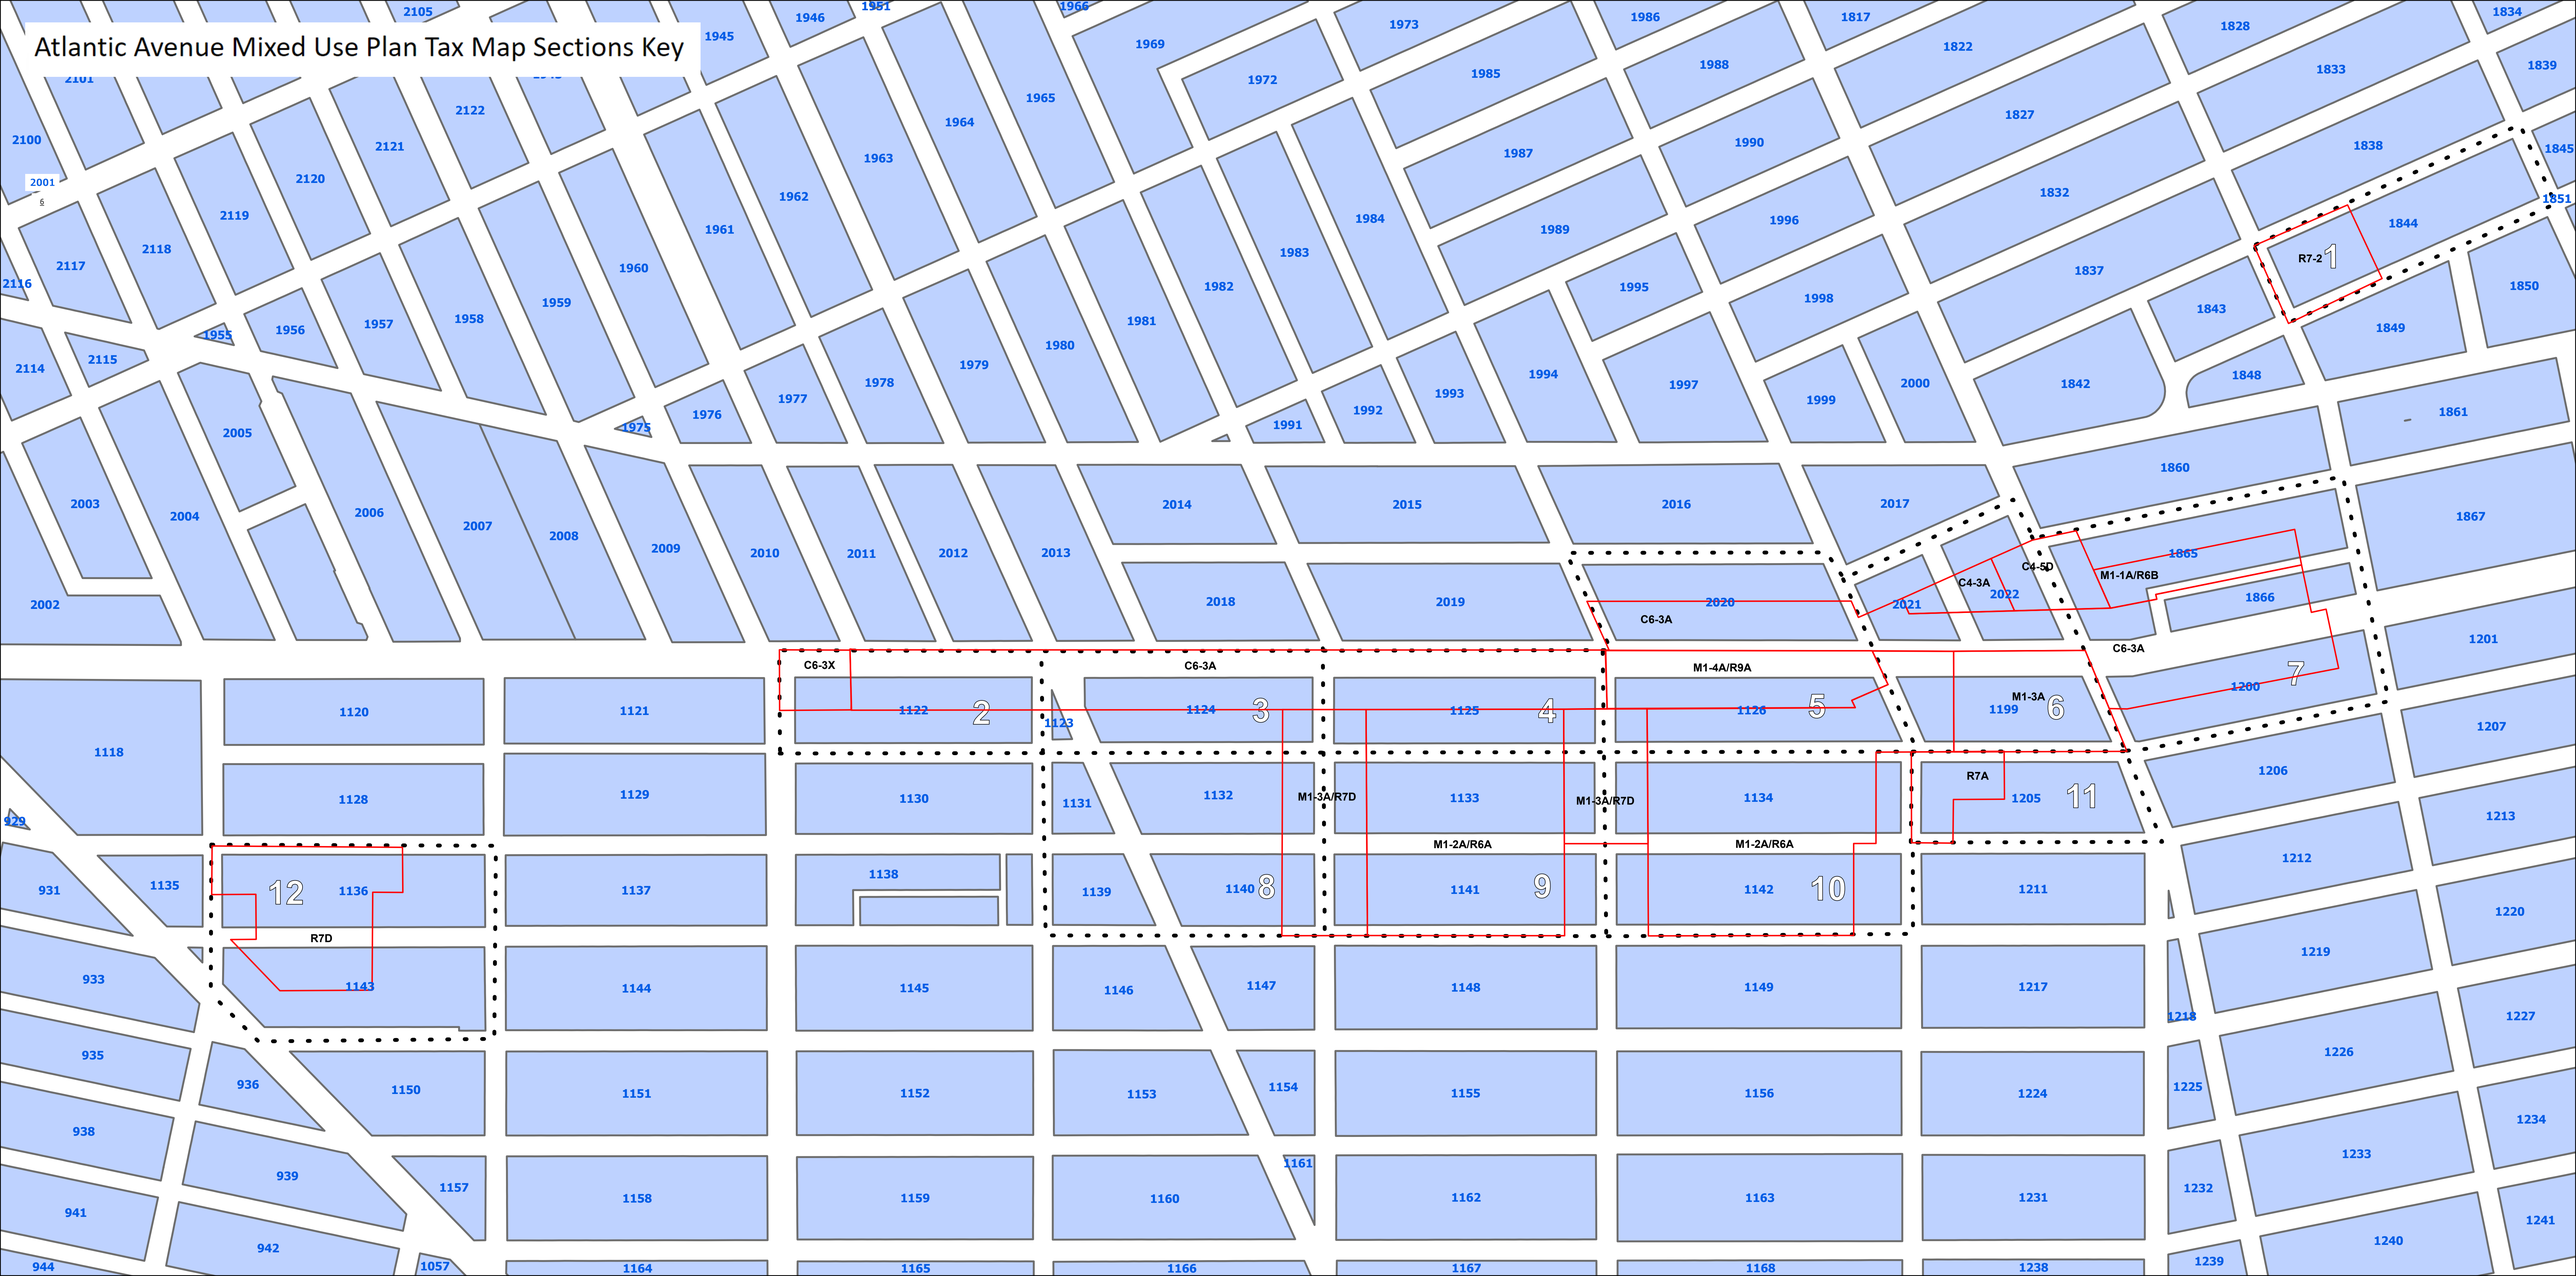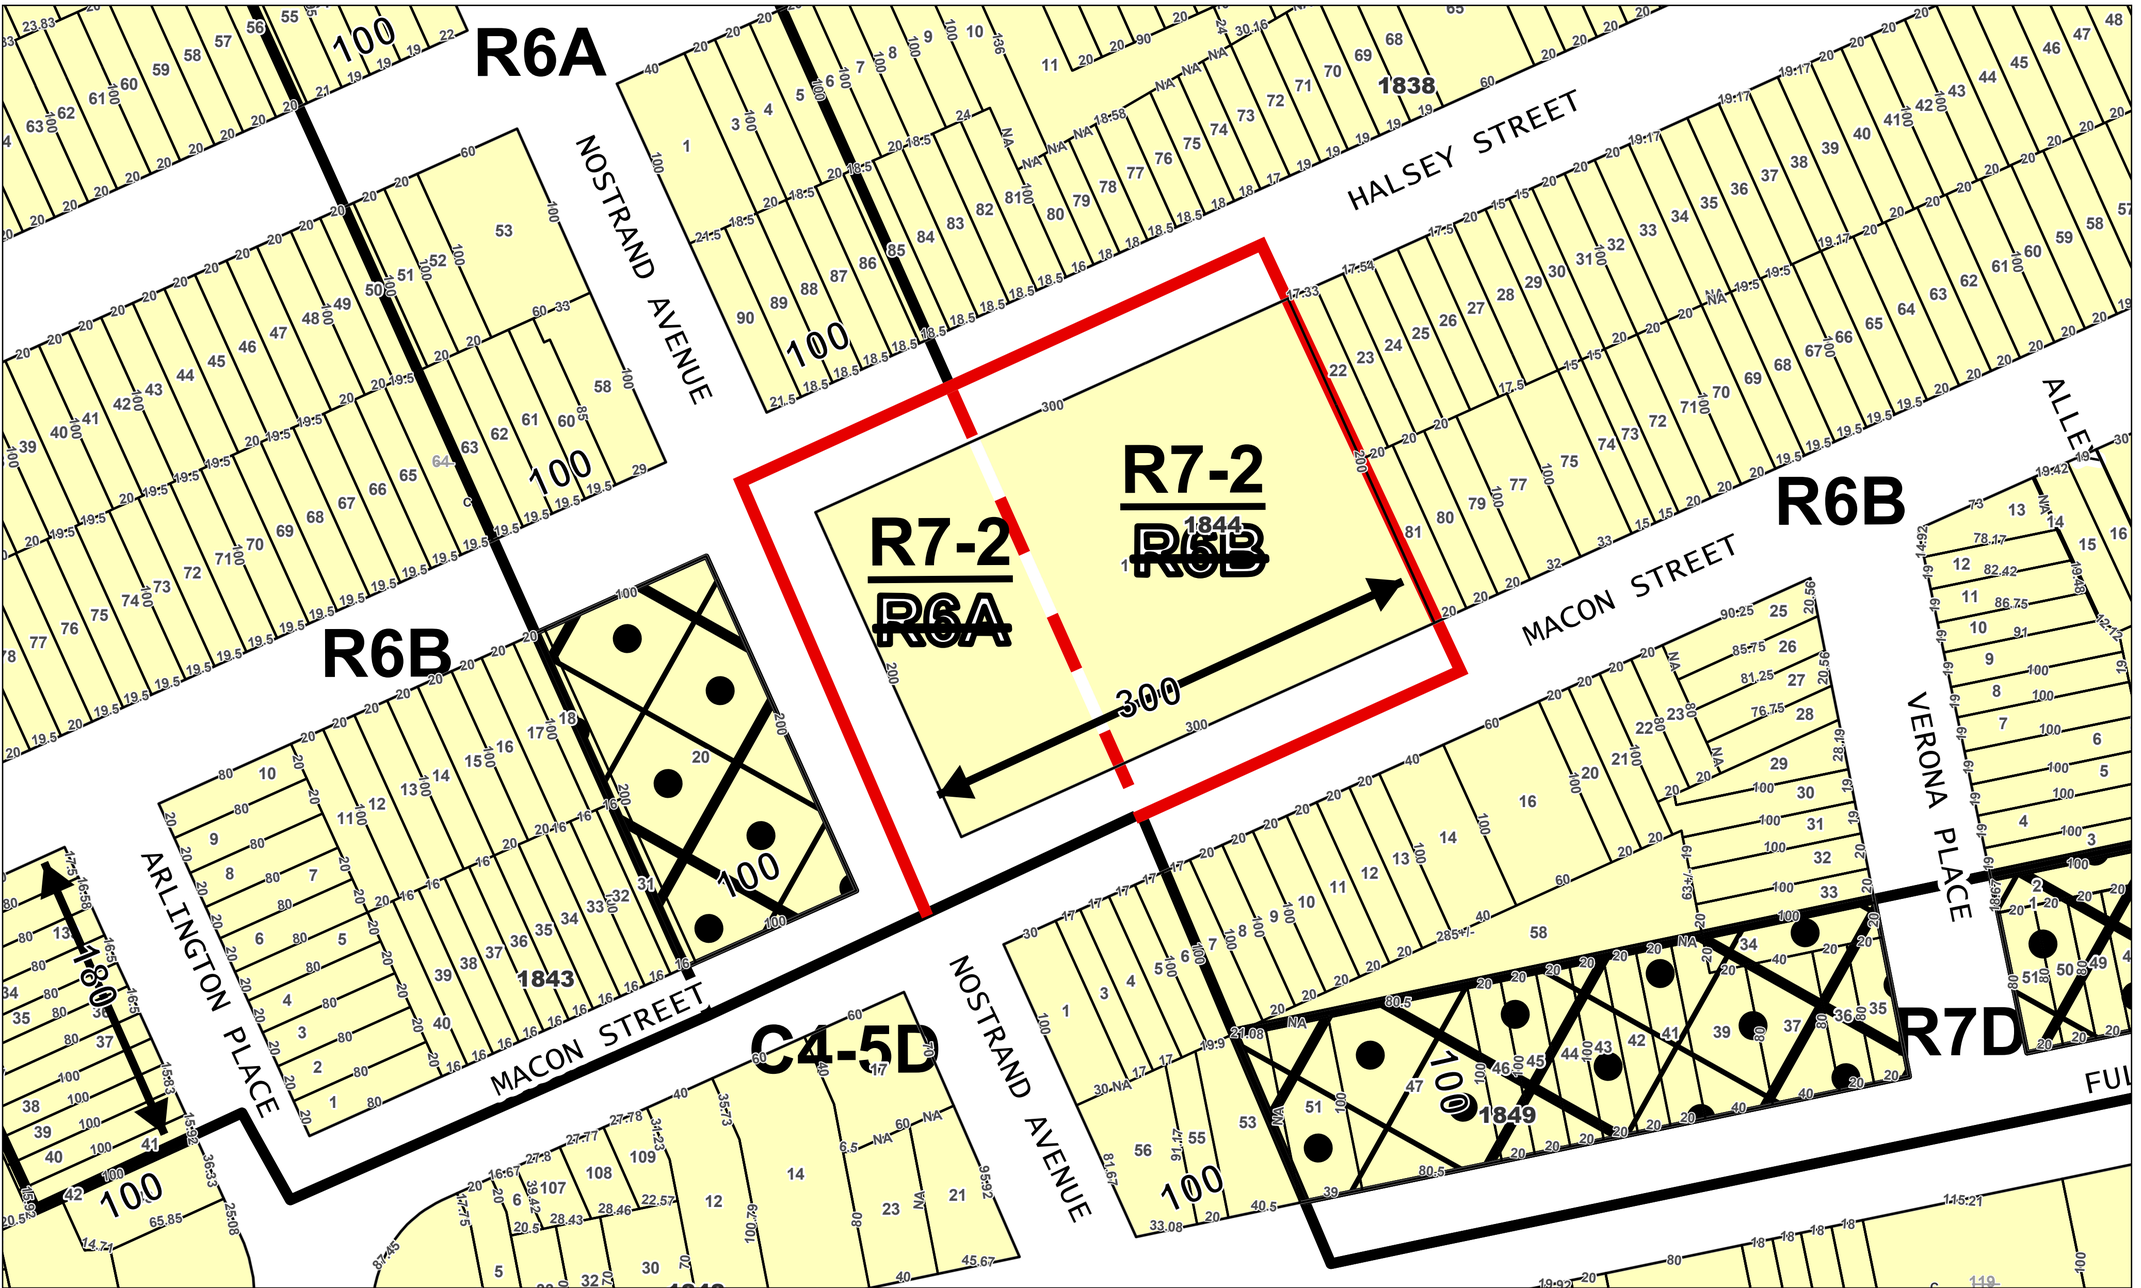

Atlantic Avenue Mixed Use Plan Map 1

Blocks: 1844

Legend

- R8A — Existing Zoning Line/District
- R6A — Eliminated Zoning Line/District
- R8A — Proposed Zoning Line/District
- AAMUP Special District
- MX-20 Removed
- C2-4 Added
- C2-4 Removed
- C1-4 No Change
- C2-3 No Change
- C2-4 No Change
- C2-5 No Change
- 6 — Tax Lot
- 2001 — Tax Block
- 1 — Possession Hooks
- Boundary Line


Note:
A tax lot with a condominium is displayed with the base lot number crossed out along with the letter "C". If the lot has Air Rights or Subterranean Rights it will be displayed with letter "A" or "S" respectively.

Data Date: 3/13/2024
Scale: 1:900

Data Source: DOF Digital Tax Map, NYCMAP 2024
Disclaimer:
This geographic information shown on this map should be used for reference. For official tax maps please contact Dept of Finance.

N

0 20 40 80 120 160 Feet

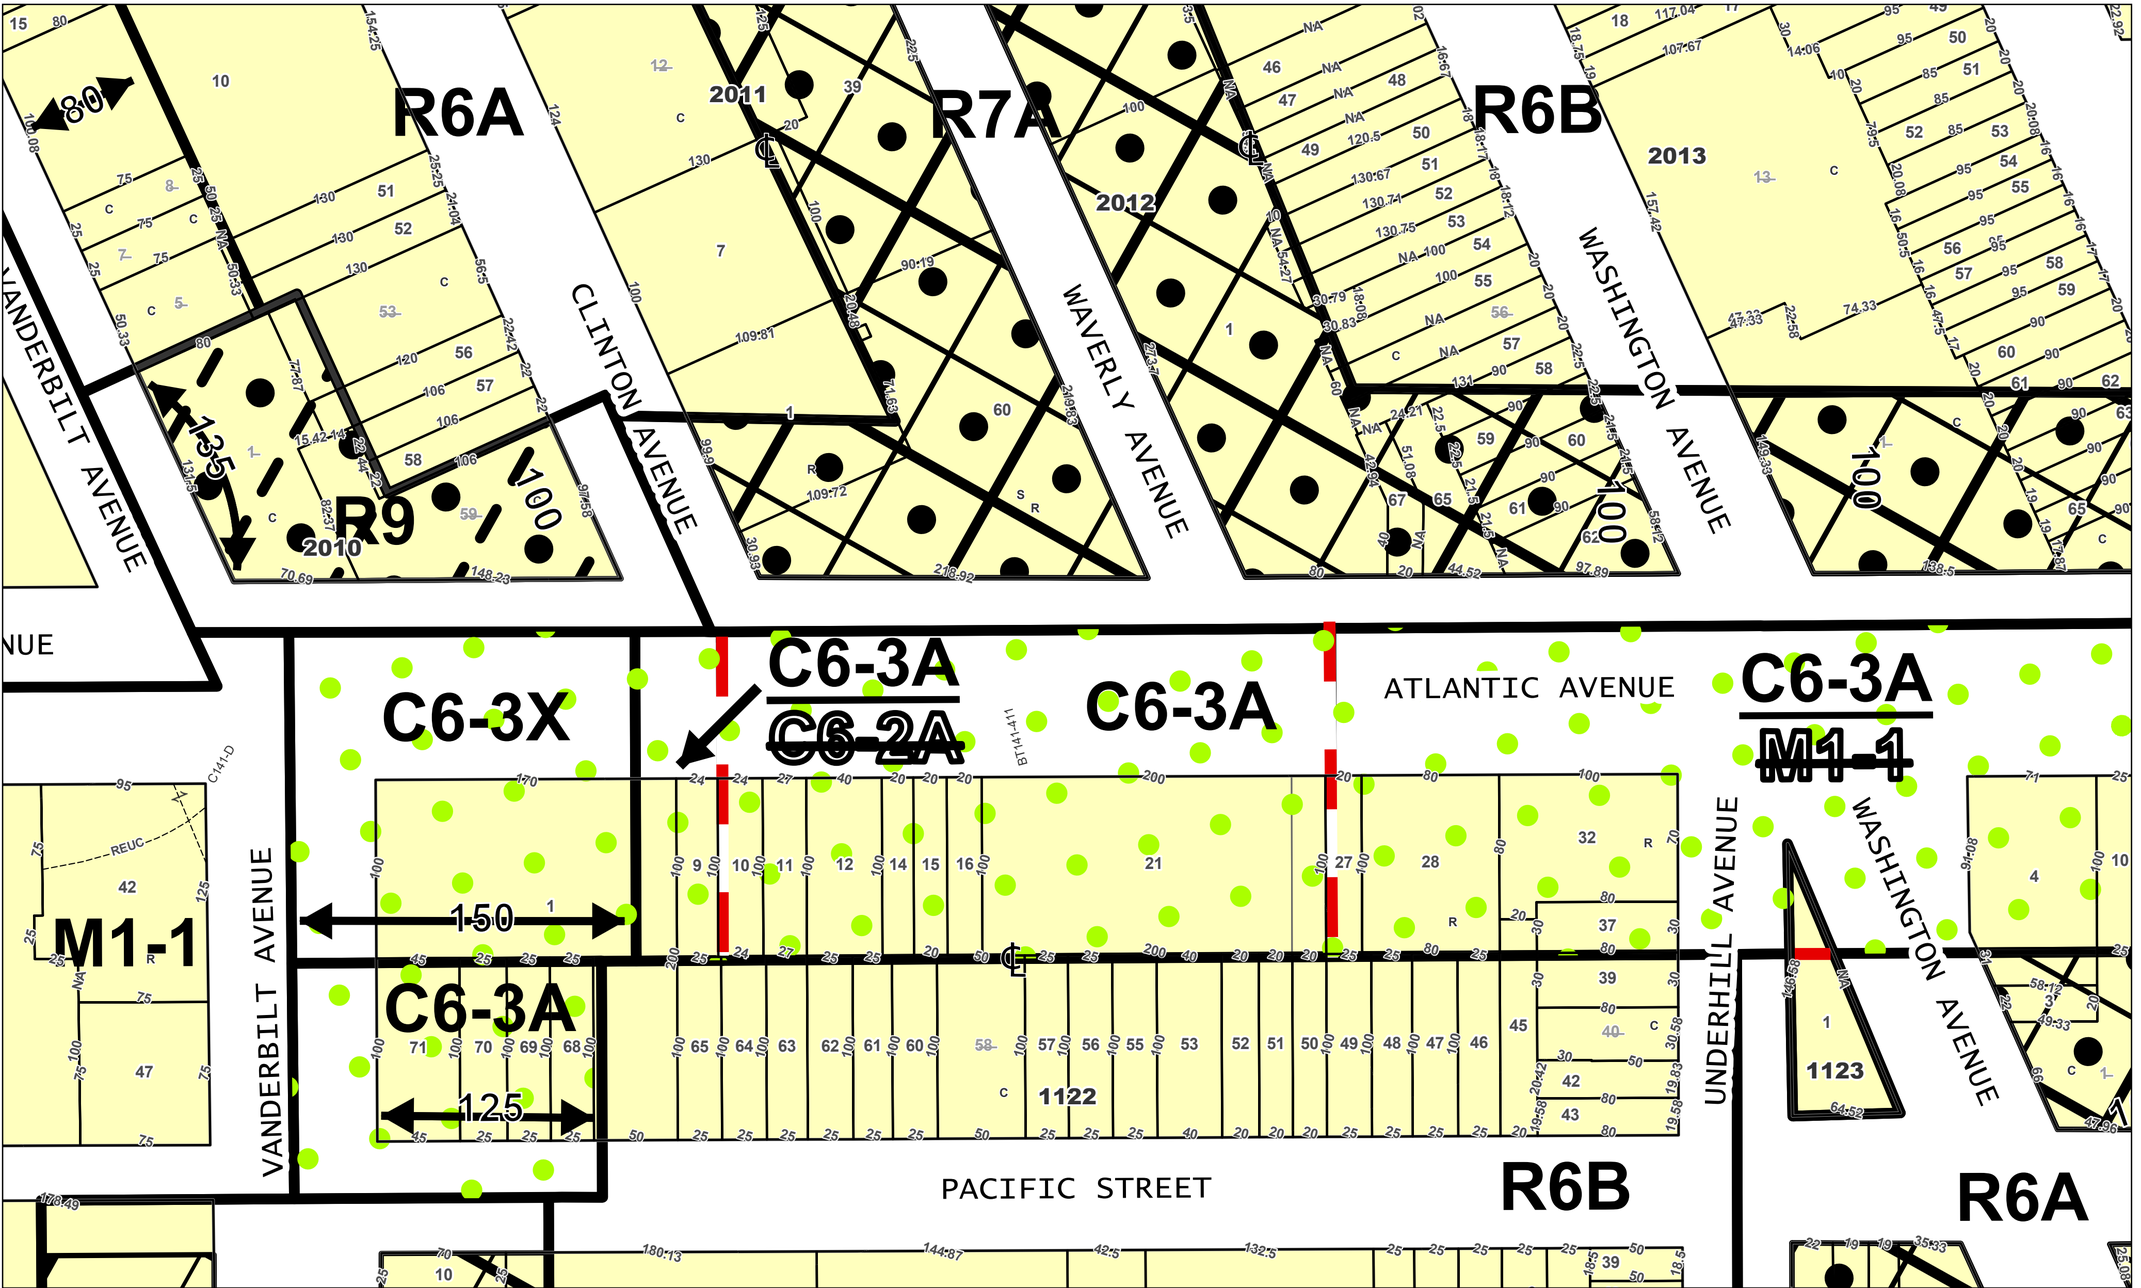

Atlantic Avenue Mixed Use Plan Map 2

Blocks: 1122

Legend

- R8A — Existing Zoning Line/District
- ~~R8A~~ — Eliminated Zoning Line/District
- R8A — Proposed Zoning Line/District
- AAMUP Special District
- MX-20 Removed
- C2-4 Added
- C2-4 Removed
- C1-4 No Change
- C2-3 No Change
- C2-4 No Change
- C2-5 No Change
- 6 — Tax Lot
- 2001 — Tax Block
- 1 — Possession Hooks
- Boundary Line


Note:
A tax lot with a condominium is displayed with the base lot number crossed out along with the letter "C". If the lot has Air Rights or Subterranean Rights it will be displayed with letter "A" or "S" respectively.

Data Date: 3/13/2024
Scale: 1:900

Data Source: DOF Digital Tax Map, NYCMAP 2024
Disclaimer:
This geographic information shown on this map should be used for reference. For official tax maps please contact Dept of Finance.

N

0 20 40 80 120 160 Feet

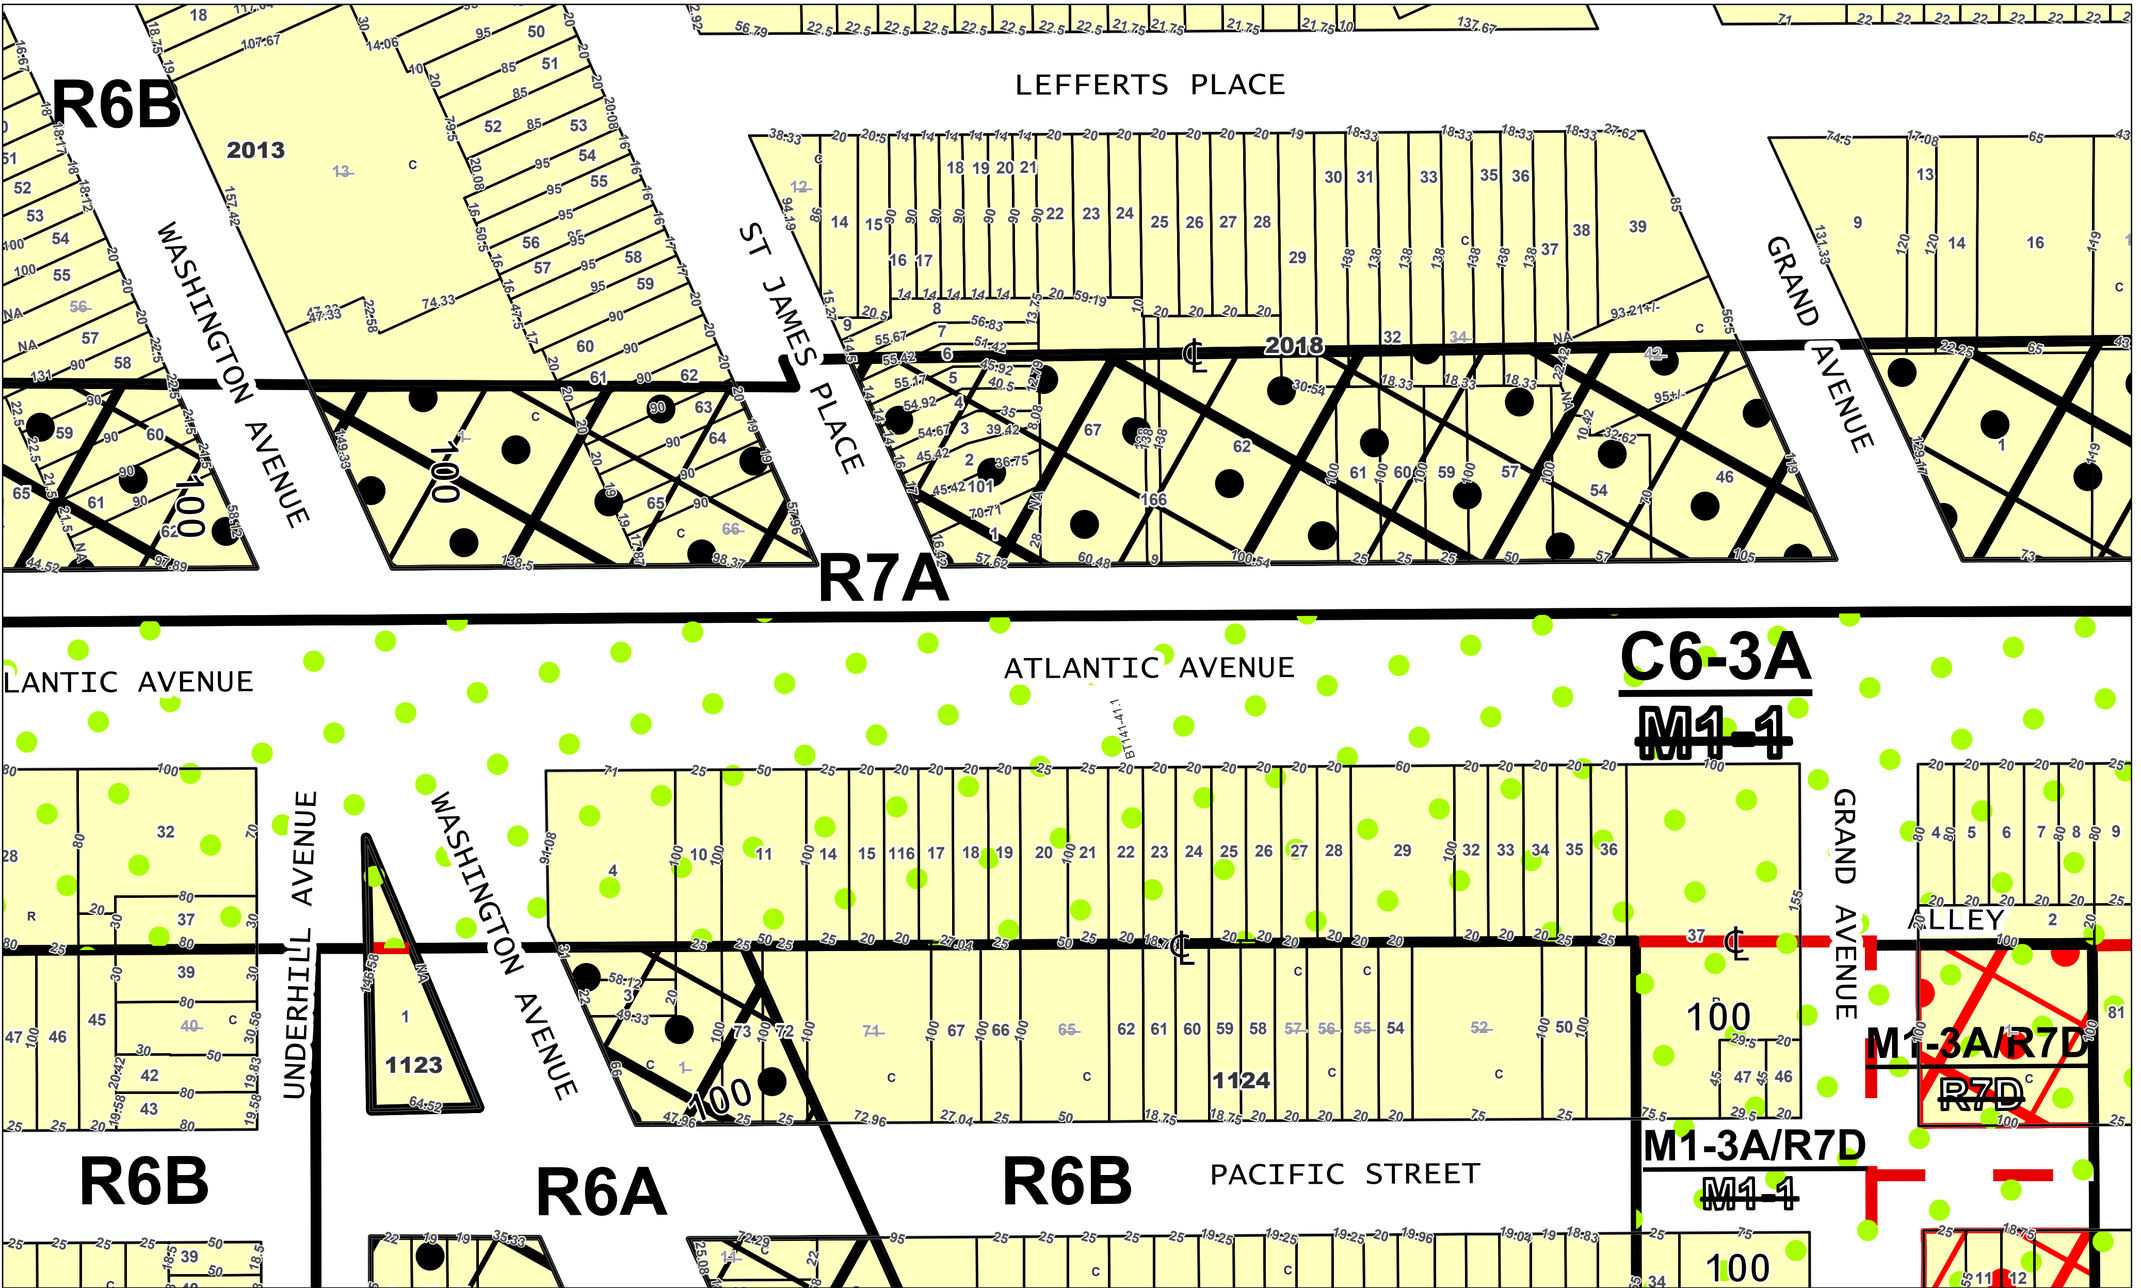

Atlantic Avenue Mixed Use Plan Map 3

Blocks: 1123 & 1124

Legend

- R8A — Existing Zoning Line/District
- R8A — Eliminated Zoning Line/District
- R8A — Proposed Zoning Line/District
- AAMUP Special District
- MX-20 Removed
- C2-4 Added
- C2-4 Removed
- C1-4 No Change
- C2-3 No Change
- C2-4 No Change
- C2-5 No Change
- 6 — Tax Lot
- 2001 — Tax Block
- 1 — Possession Hooks
- Boundary Line


Note:
A tax lot with a condominium is displayed with the base lot number crossed out along with the letter "C". If the lot has Air Rights or Subterranean Rights it will be displayed with letter "A" or "S" respectively.

Data Date: 3/13/2024
Scale: 1:900

Data Source: DOF Digital Tax Map, NYCMAP 2024
Disclaimer:
This geographic information shown on this map should be used for reference. For official tax maps please contact Dept of Finance.

N

0 20 40 80 120 160 Feet

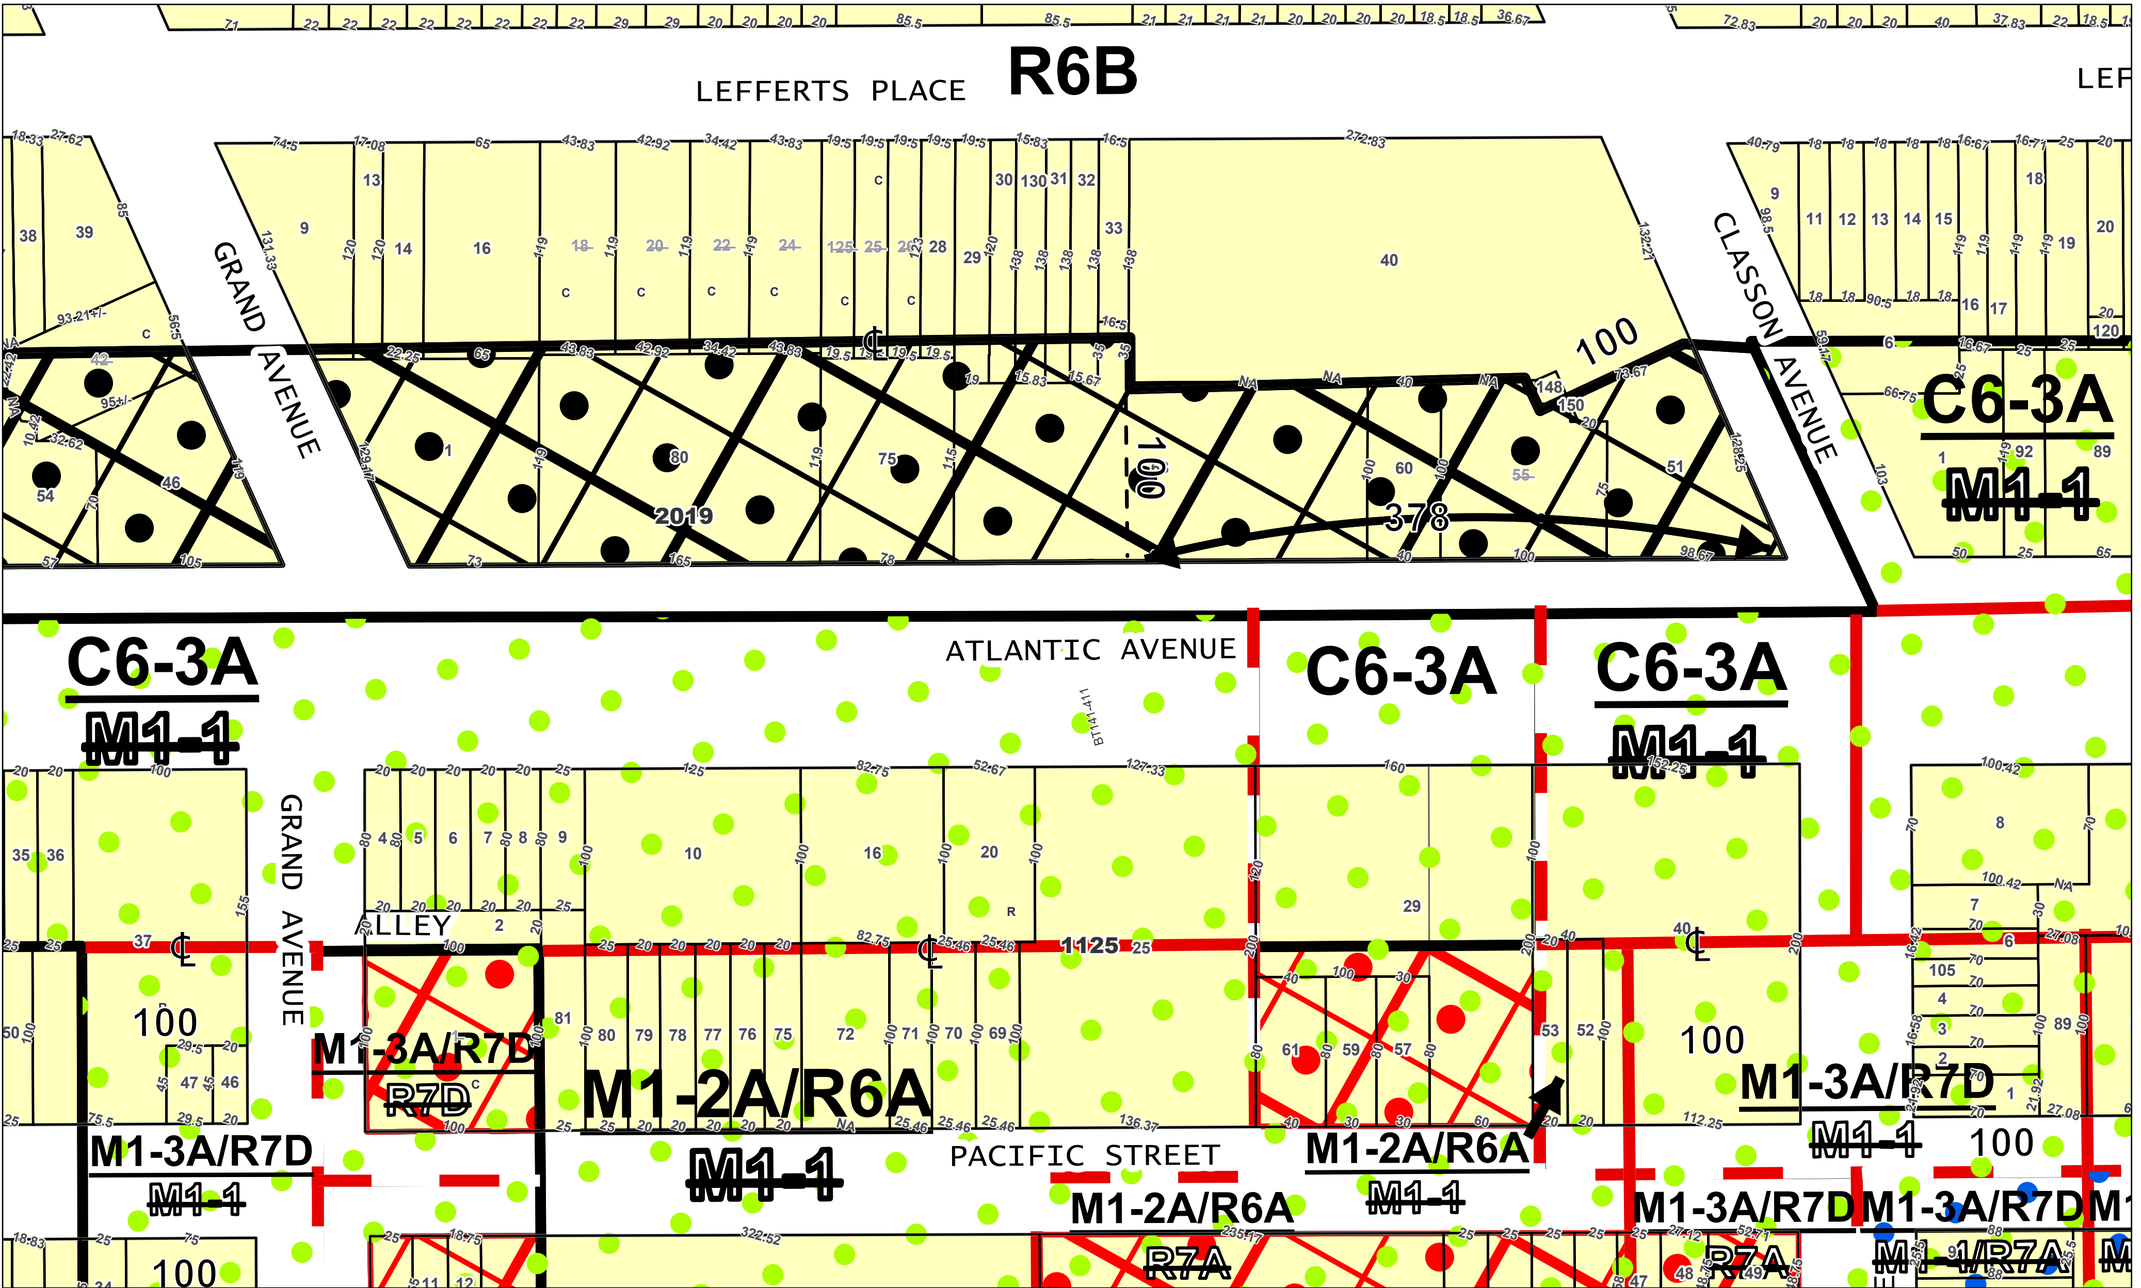

Atlantic Avenue Mixed Use Plan Map 4

Blocks: 1125

Legend

- R8A — Existing Zoning Line/District
- R8A — Eliminated Zoning Line/District
- R8A — Proposed Zoning Line/District
- AAMUP Special District
- MX-20 Removed
- C2-4 Added
- C2-4 Removed
- C1-4 No Change
- C2-3 No Change
- C2-4 No Change
- C2-5 No Change
- 6 — Tax Lot
- 2001 — Tax Block
- 1 — Possession Hooks
- Boundary Line


Note:
A tax lot with a condominium is displayed with the base lot number crossed out along with the letter "C". If the lot has Air Rights or Subterranean Rights it will be displayed with letter "A" or "S" respectively.

Data Date: 3/13/2024
Scale: 1:900

Data Source: DOF Digital Tax Map, NYCMAP 2024
Disclaimer:
This geographic information shown on this map should be used for reference. For official tax maps please contact Dept of Finance.

N

0 20 40 80 120 160 Feet

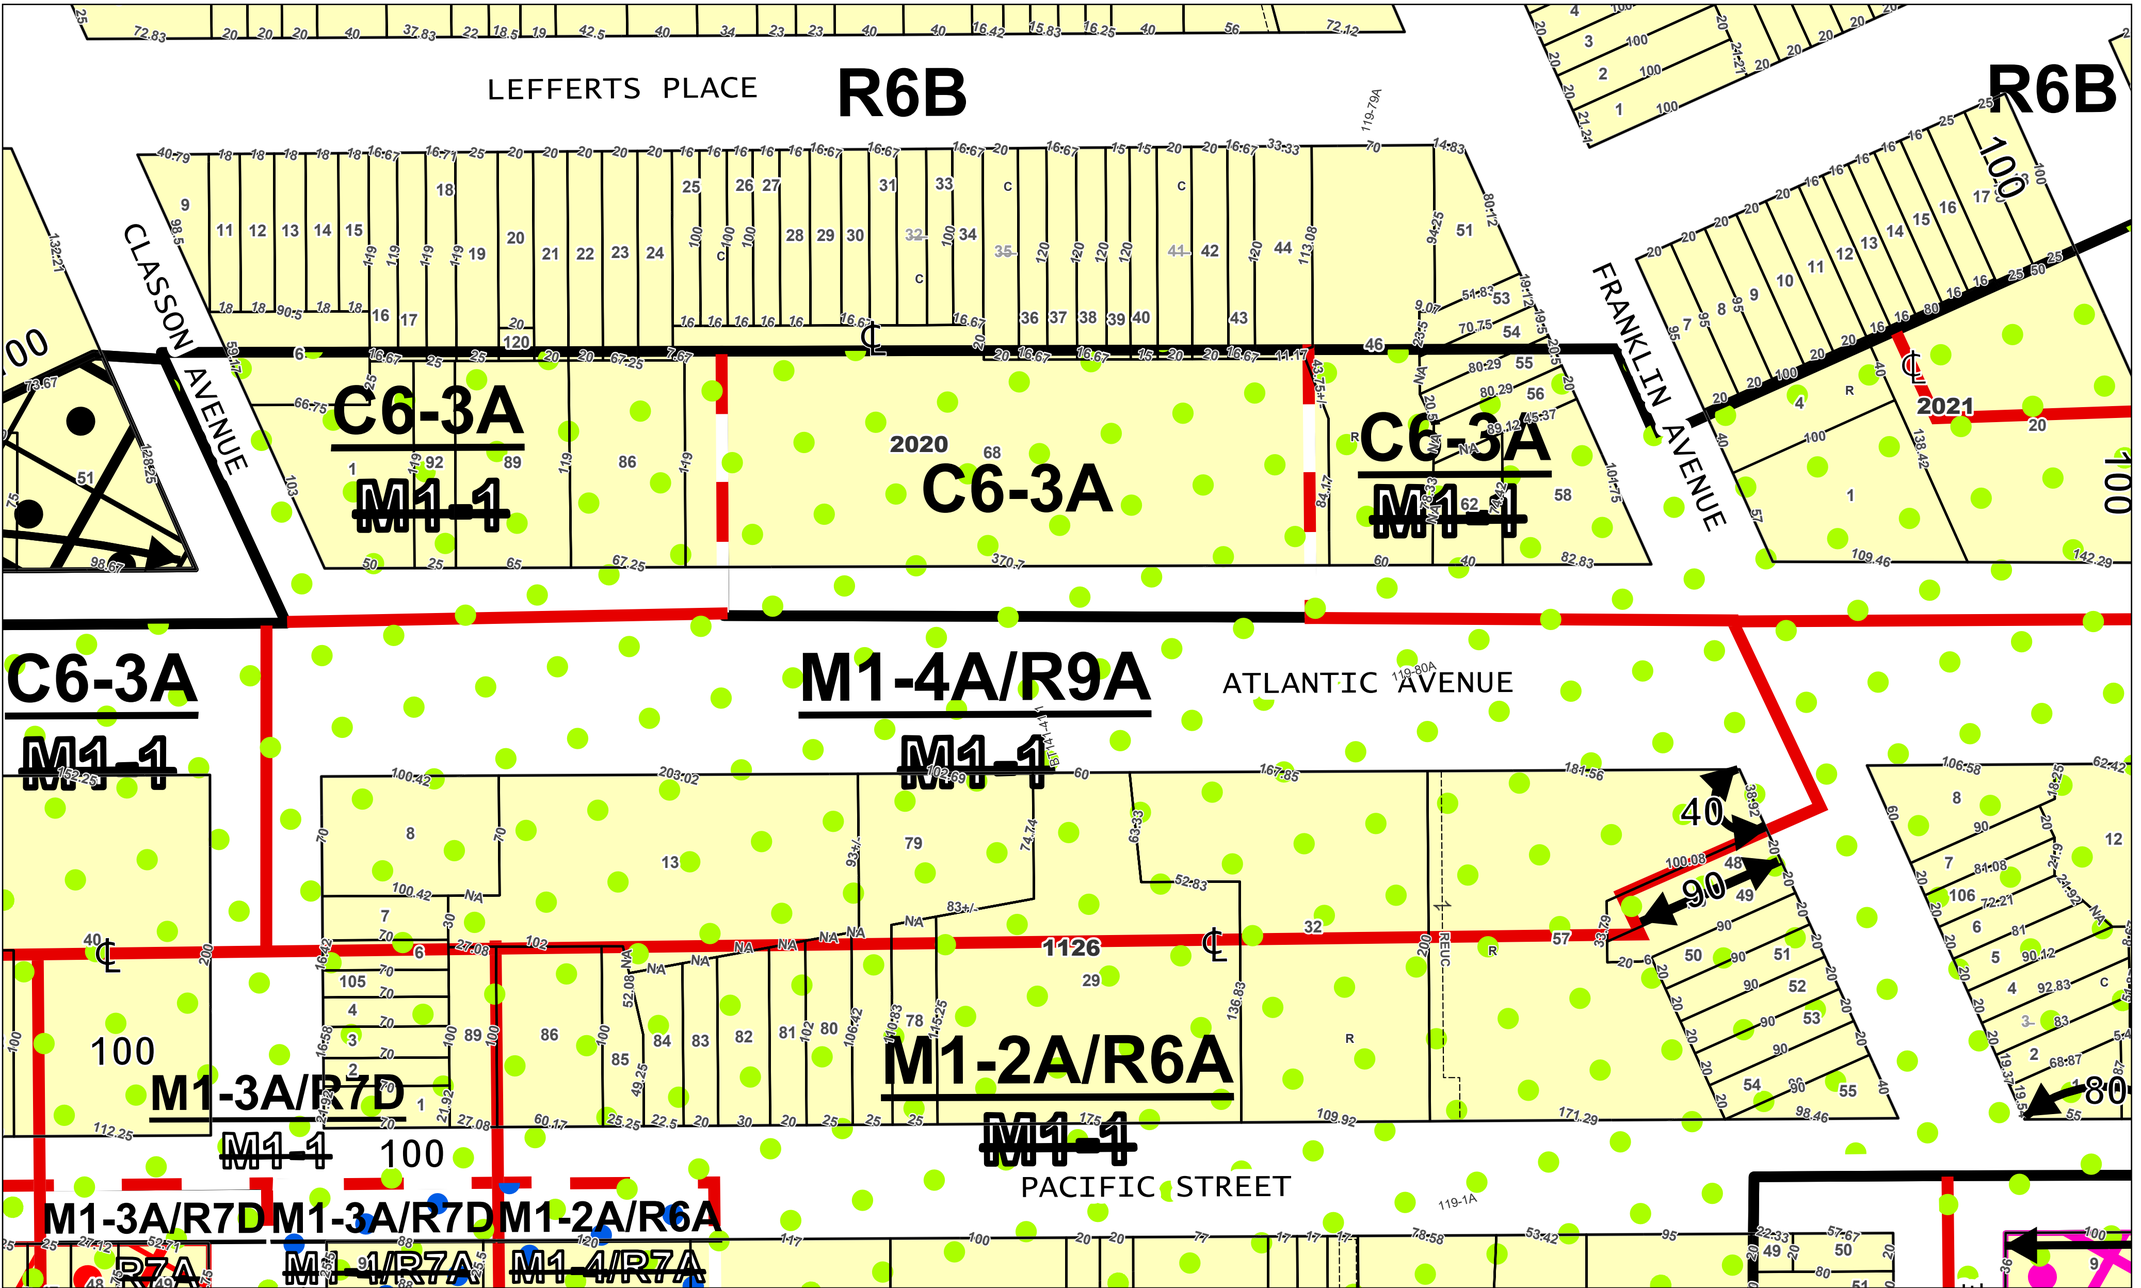

Atlantic Avenue Mixed Use Plan Map 5

Blocks: 1126

Legend

- R8A — Existing Zoning Line/District
- R8A — Eliminated Zoning Line/District
- R8A — Proposed Zoning Line/District
- AAMUP Special District
- MX-20 Removed
- C2-4 Added
- C2-4 Removed
- C1-4 No Change
- C2-3 No Change
- C2-4 No Change
- C2-5 No Change
- 6 — Tax Lot
- 2001 — Tax Block
- 1 — Possession Hooks
- Boundary Line


Note:
A tax lot with a condominium is displayed with the base lot number crossed out along with the letter "C". If the lot has Air Rights or Subterranean Rights it will be displayed with letter "A" or "S" respectively.

Data Date: 3/13/2024
Scale: 1:900

Data Source: DOF Digital Tax Map, NYCMAP 2024
Disclaimer:
This geographic information shown on this map should be used for reference. For official tax maps please contact Dept of Finance.

N

0 20 40 80 120 160 Feet

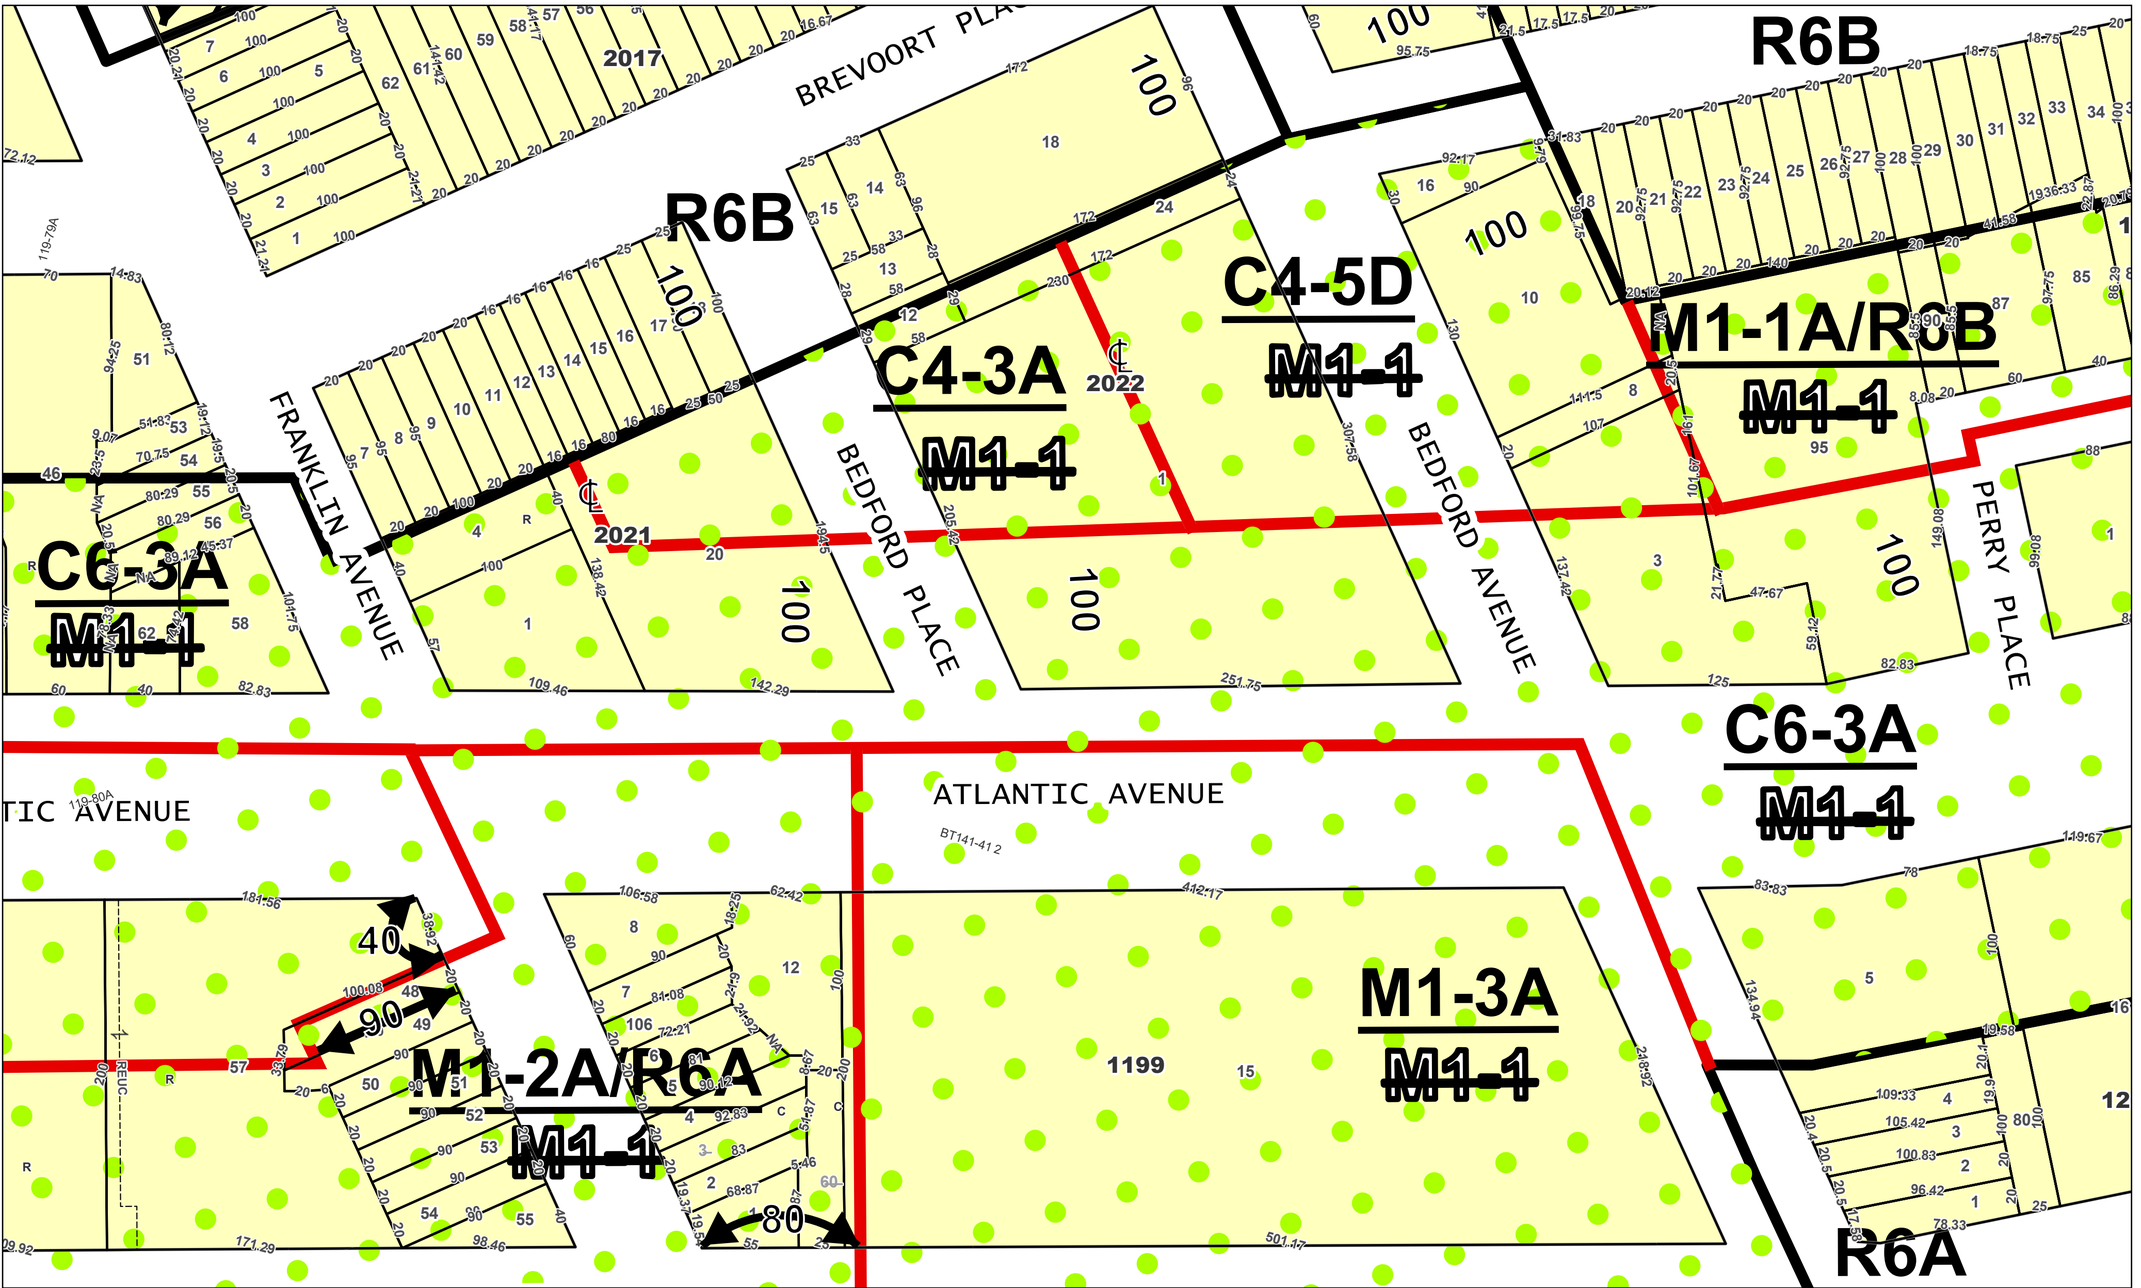

Atlantic Avenue Mixed Use Plan Map 6

Blocks: 1199, 2021 & 2022

Legend

- R8A — Existing Zoning Line/District
- R8A — Eliminated Zoning Line/District
- R8A — Proposed Zoning Line/District
- AAMUP Special District
- MX-20 Removed
- C2-4 Added
- C2-4 Removed
- C1-4 No Change
- C2-3 No Change
- C2-4 No Change
- C2-5 No Change
- 6 — Tax Lot
- 2001 — Tax Block
- 1 — Possession Hooks
- Boundary Line


Note:
A tax lot with a condominium is displayed with the base lot number crossed out along with the letter "C". If the lot has Air Rights or Subterranean Rights it will be displayed with letter "A" or "S" respectively.

Data Date: 3/13/2024
Scale: 1:900

Data Source: DOF Digital Tax Map, NYCMAP 2024
Disclaimer:
This geographic information shown on this map should be used for reference. For official tax maps please contact Dept of Finance.

N

0 20 40 80 120 160 Feet

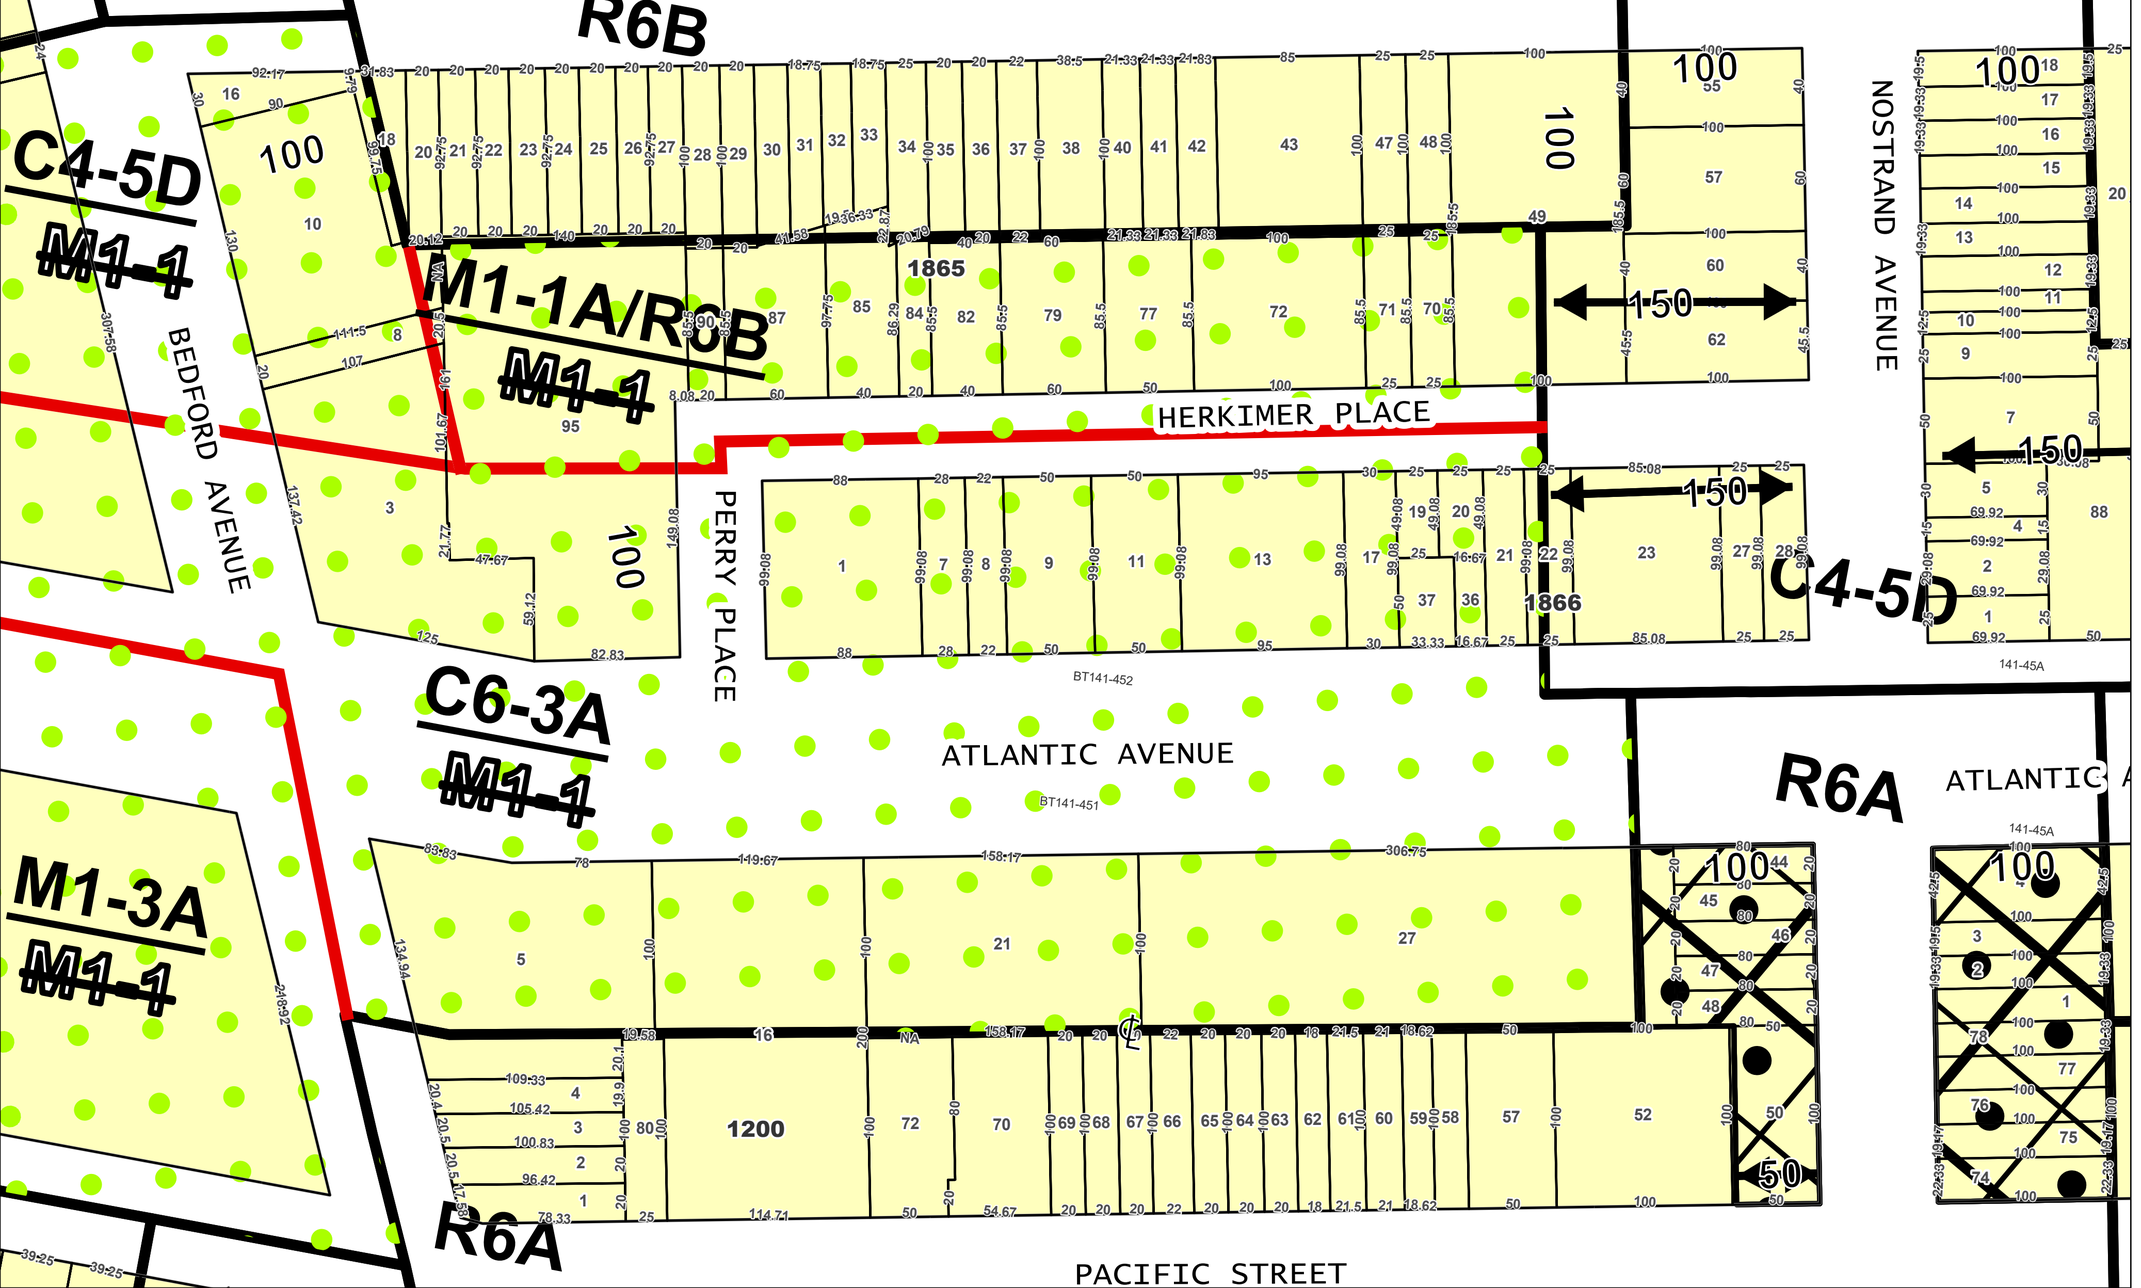

Atlantic Avenue Mixed Use Plan Map 7

Blocks: 1200, 1865 & 1866

Legend

- R8A — Existing Zoning Line/District
- R8A — Eliminated Zoning Line/District
- R8A — Proposed Zoning Line/District
- AAMUP Special District
- MX-20 Removed
- C2-4 Added
- C2-4 Removed
- C1-4 No Change
- C2-3 No Change
- C2-4 No Change
- C2-5 No Change
- 6 — Tax Lot
- 2001 — Tax Block
- 1 — Possession Hooks
- Boundary Line


Note:
A tax lot with a condominium is displayed with the base lot number crossed out along with the letter "C". If the lot has Air Rights or Subterranean Rights it will be displayed with letter "A" or "S" respectively.

Data Date: 3/13/2024
Scale: 1:900

Data Source: DOF Digital Tax Map, NYCMAP 2024
Disclaimer:
This geographic information shown on this map should be used for reference. For official tax maps please contact Dept of Finance.

N

0 20 40 80 120 160 Feet

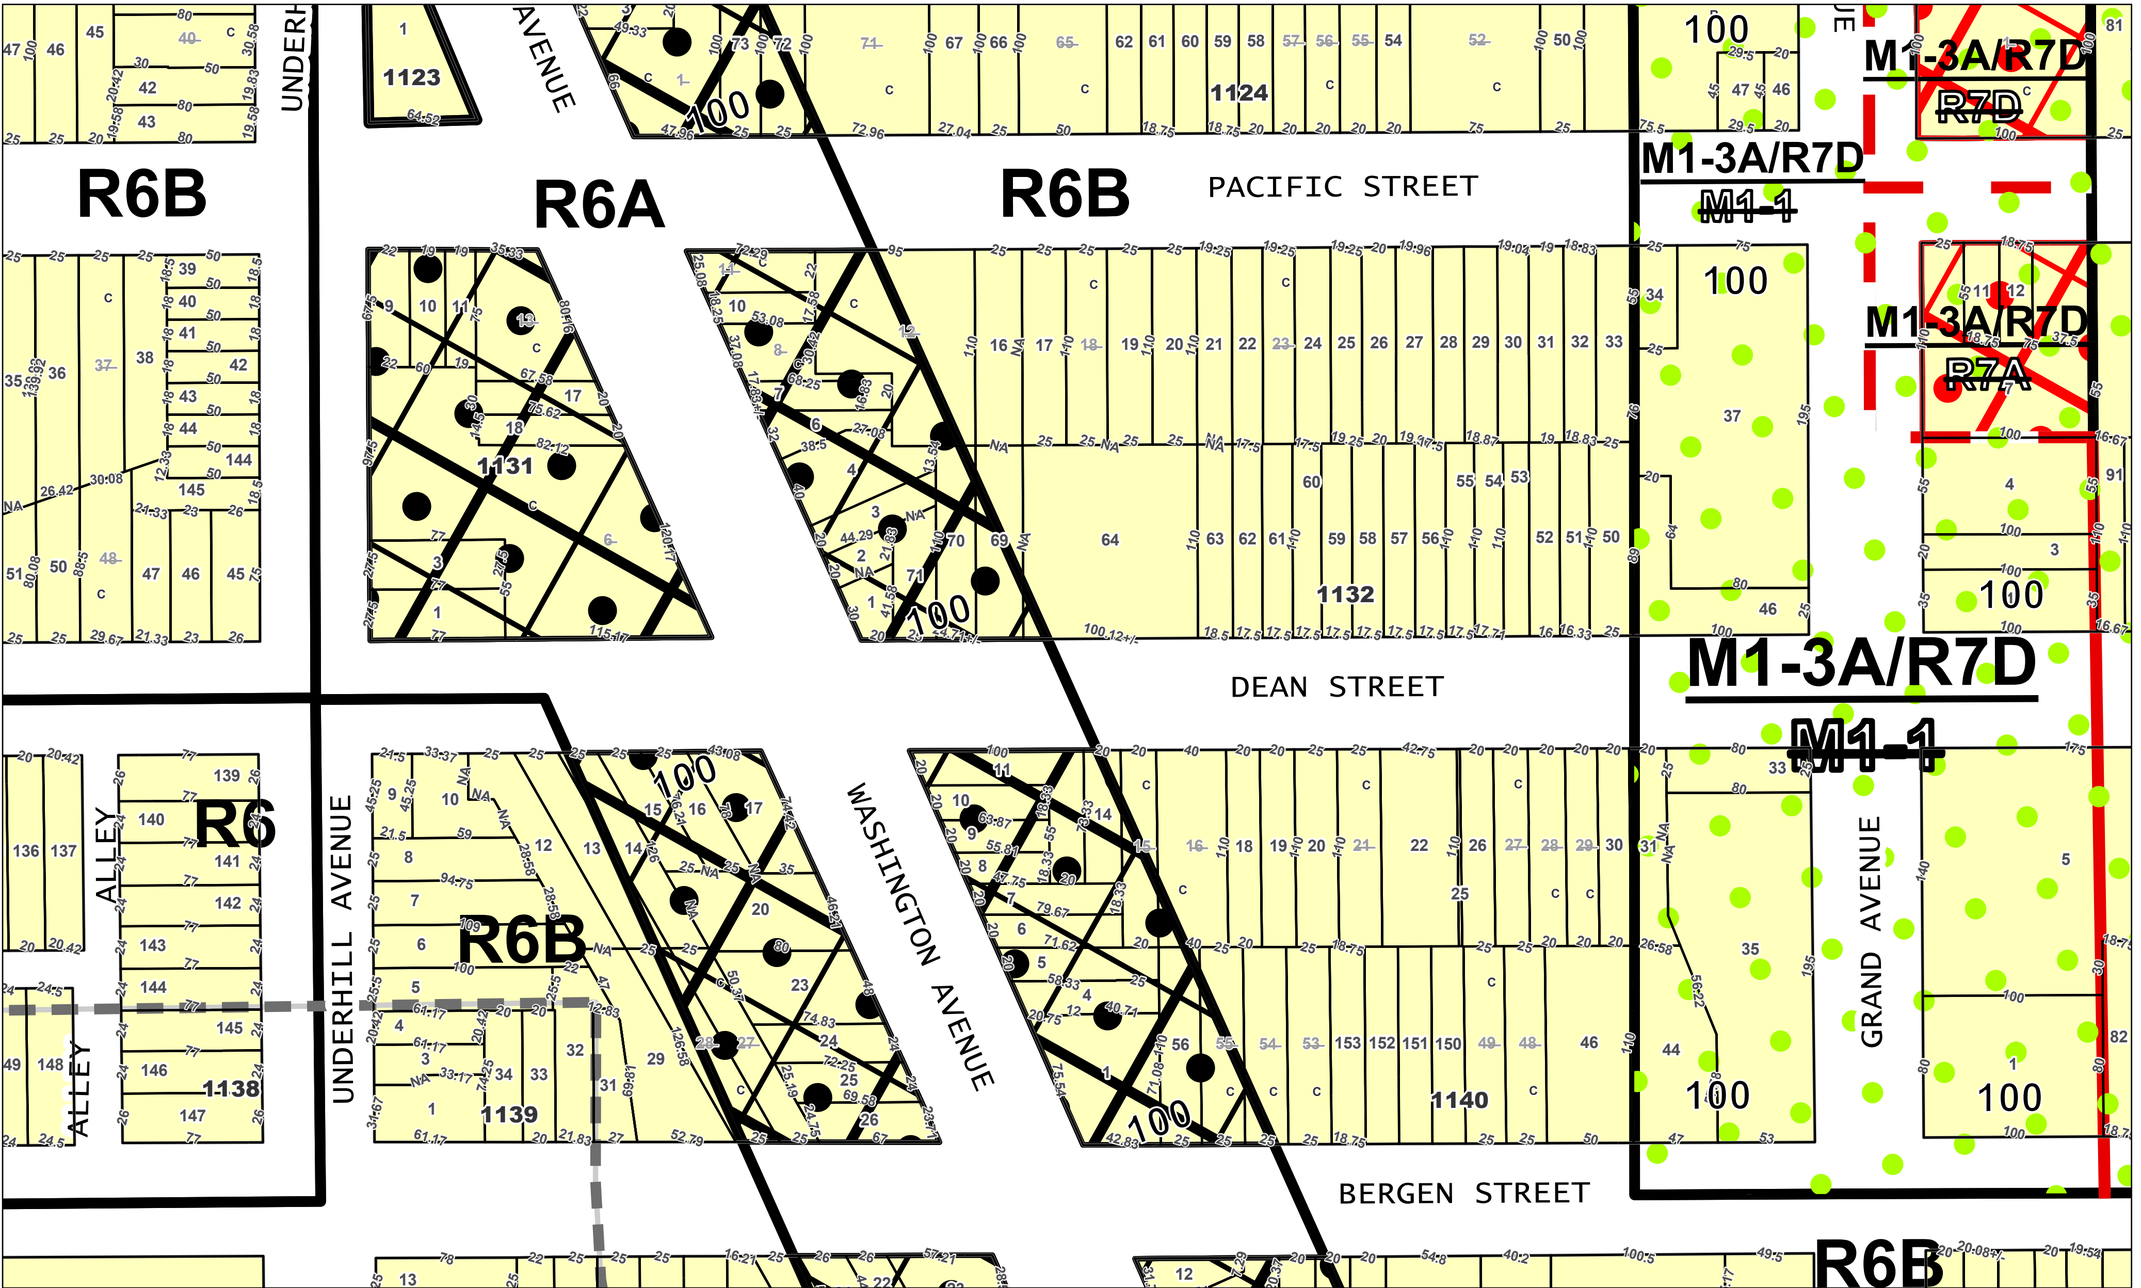

Atlantic Avenue Mixed Use Plan Map 8

Blocks: 1132 & 1140

Legend

- R8A — Existing Zoning Line/District
- ~~R8A~~ — Eliminated Zoning Line/District
- R8A — Proposed Zoning Line/District
- AAMUP Special District
- MX-20 Removed
- C2-4 Added
- C2-4 Removed
- C1-4 No Change
- C2-3 No Change
- C2-4 No Change
- C2-5 No Change
- 6 — Tax Lot
- 2001 — Tax Block
- 1 — Possession Hooks
- Boundary Line


Note:
A tax lot with a condominium is displayed with the base lot number crossed out along with the letter "C". If the lot has Air Rights or Subterranean Rights it will be displayed with letter "A" or "S" respectively.

Data Date: 3/13/2024
Scale: 1:900

Data Source: DOF Digital Tax Map, NYCMAP 2024
Disclaimer:
This geographic information shown on this map should be used for reference. For official tax maps please contact Dept of Finance.

N

0 20 40 80 120 160 Feet

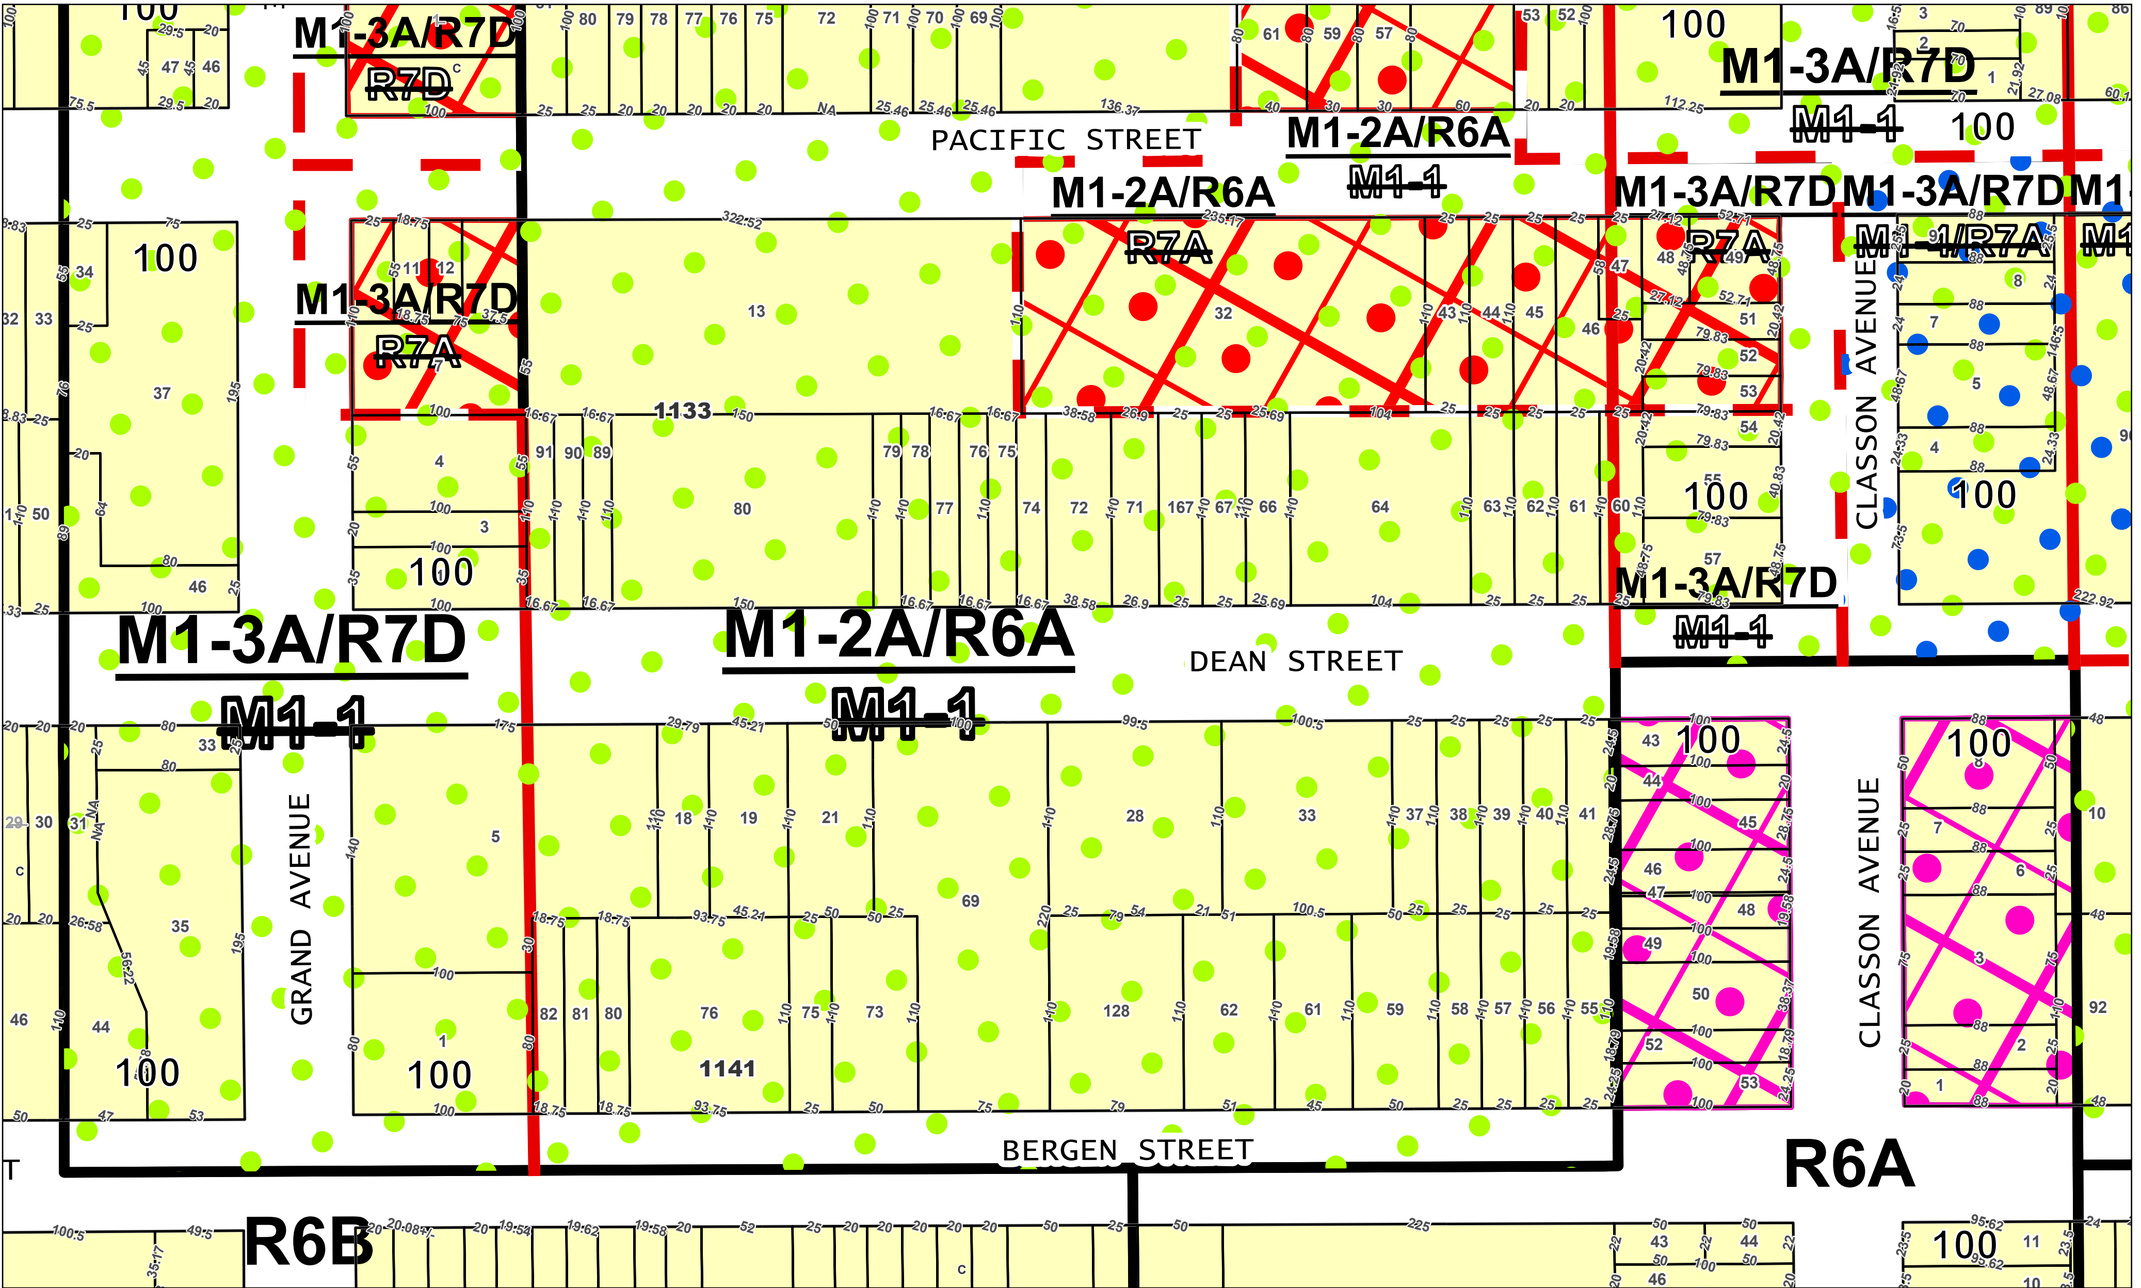

Atlantic Avenue Mixed Use Plan Map 9

Blocks: 1133 & 1141

Legend

- Existing Zoning Line/District
- Eliminated Zoning Line/District
- Proposed Zoning Line/District
- AAMUP Special District
- MX-20 Removed
- C2-4 Added
- C2-4 Removed
- C1-4 No Change
- C2-3 No Change
- C2-4 No Change
- C2-5 No Change
- Tax Lot
- Tax Block
- Possession Hooks
- Boundary Line


Note:
A tax lot with a condominium is displayed with the base lot number crossed out along with the letter "C". If the lot has Air Rights or Subterranean Rights it will be displayed with letter "A" or "S" respectively.

Data Date: 3/13/2024
Scale: 1:900

Data Source: DOF Digital Tax Map, NYCMAP 2024
Disclaimer:
This geographic information shown on this map should be used for reference. For official tax maps please contact Dept of Finance.

N

0 20 40 80 120 160 Feet

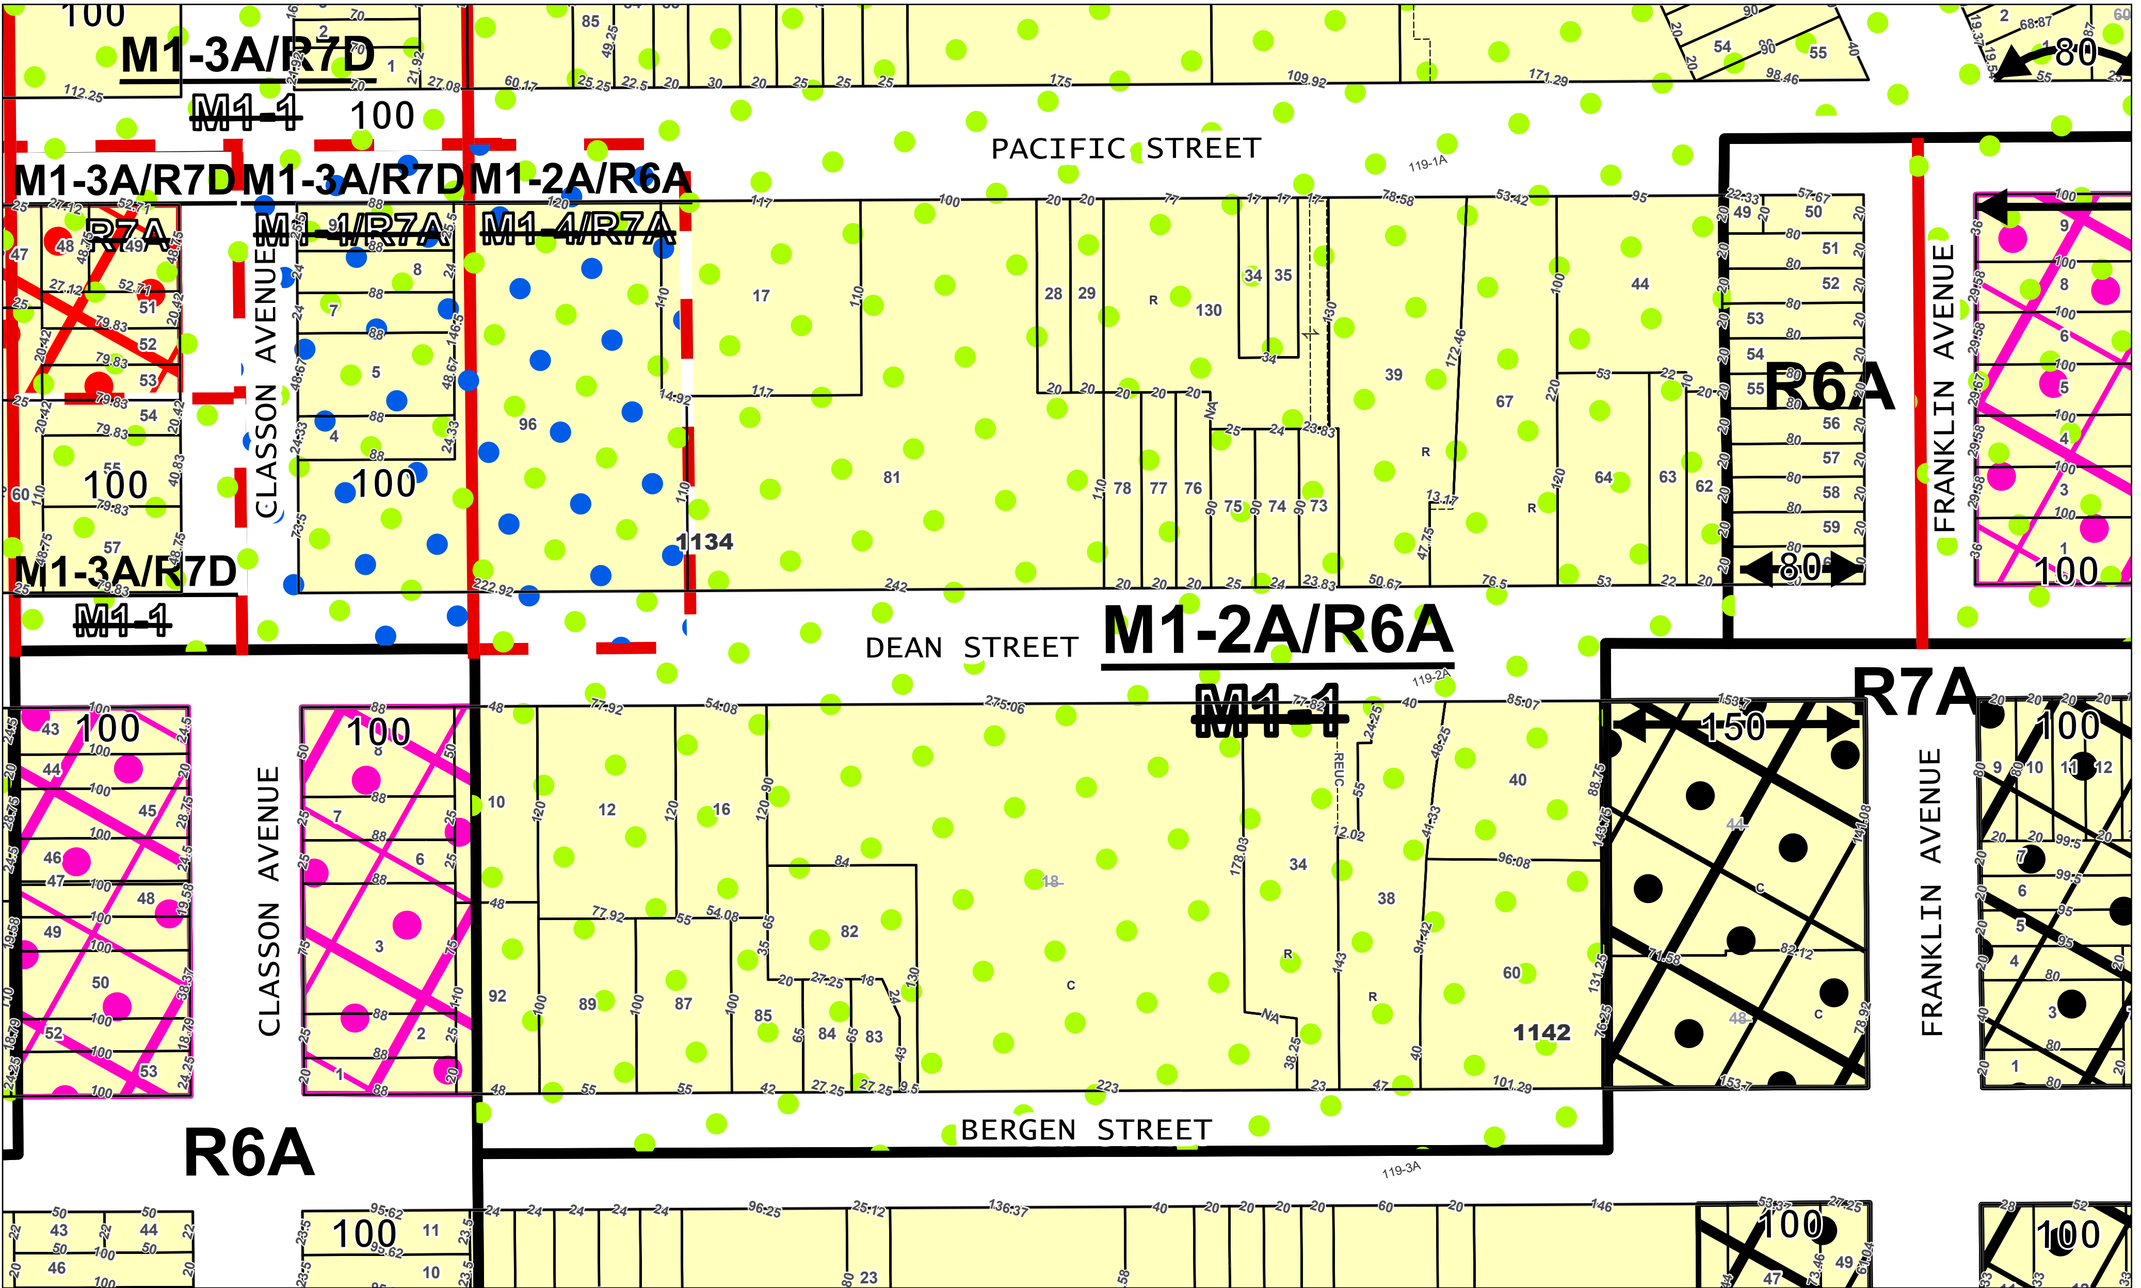

Atlantic Avenue Mixed Use Plan Map 10

Blocks: 1134 & 1142

Legend

- R8A — Existing Zoning Line/District
- R8A — Eliminated Zoning Line/District
- R8A — Proposed Zoning Line/District
- AAMUP Special District
- MX-20 Removed
- C2-4 Added
- C2-4 Removed
- C1-4 No Change
- C2-3 No Change
- C2-4 No Change
- C2-5 No Change
- 6 — Tax Lot
- 2001 — Tax Block
- 1 — Possession Hooks
- Boundary Line


Note:
A tax lot with a condominium is displayed with the base lot number crossed out along with the letter "C". If the lot has Air Rights or Subterranean Rights it will be displayed with letter "A" or "S" respectively.

Data Date: 3/13/2024
Scale: 1:900

Data Source: DOF Digital Tax Map, NYCMAP 2024
Disclaimer:
This geographic information shown on this map should be used for reference. For official tax maps please contact Dept of Finance.

N

0 20 40 80 120 160 Feet

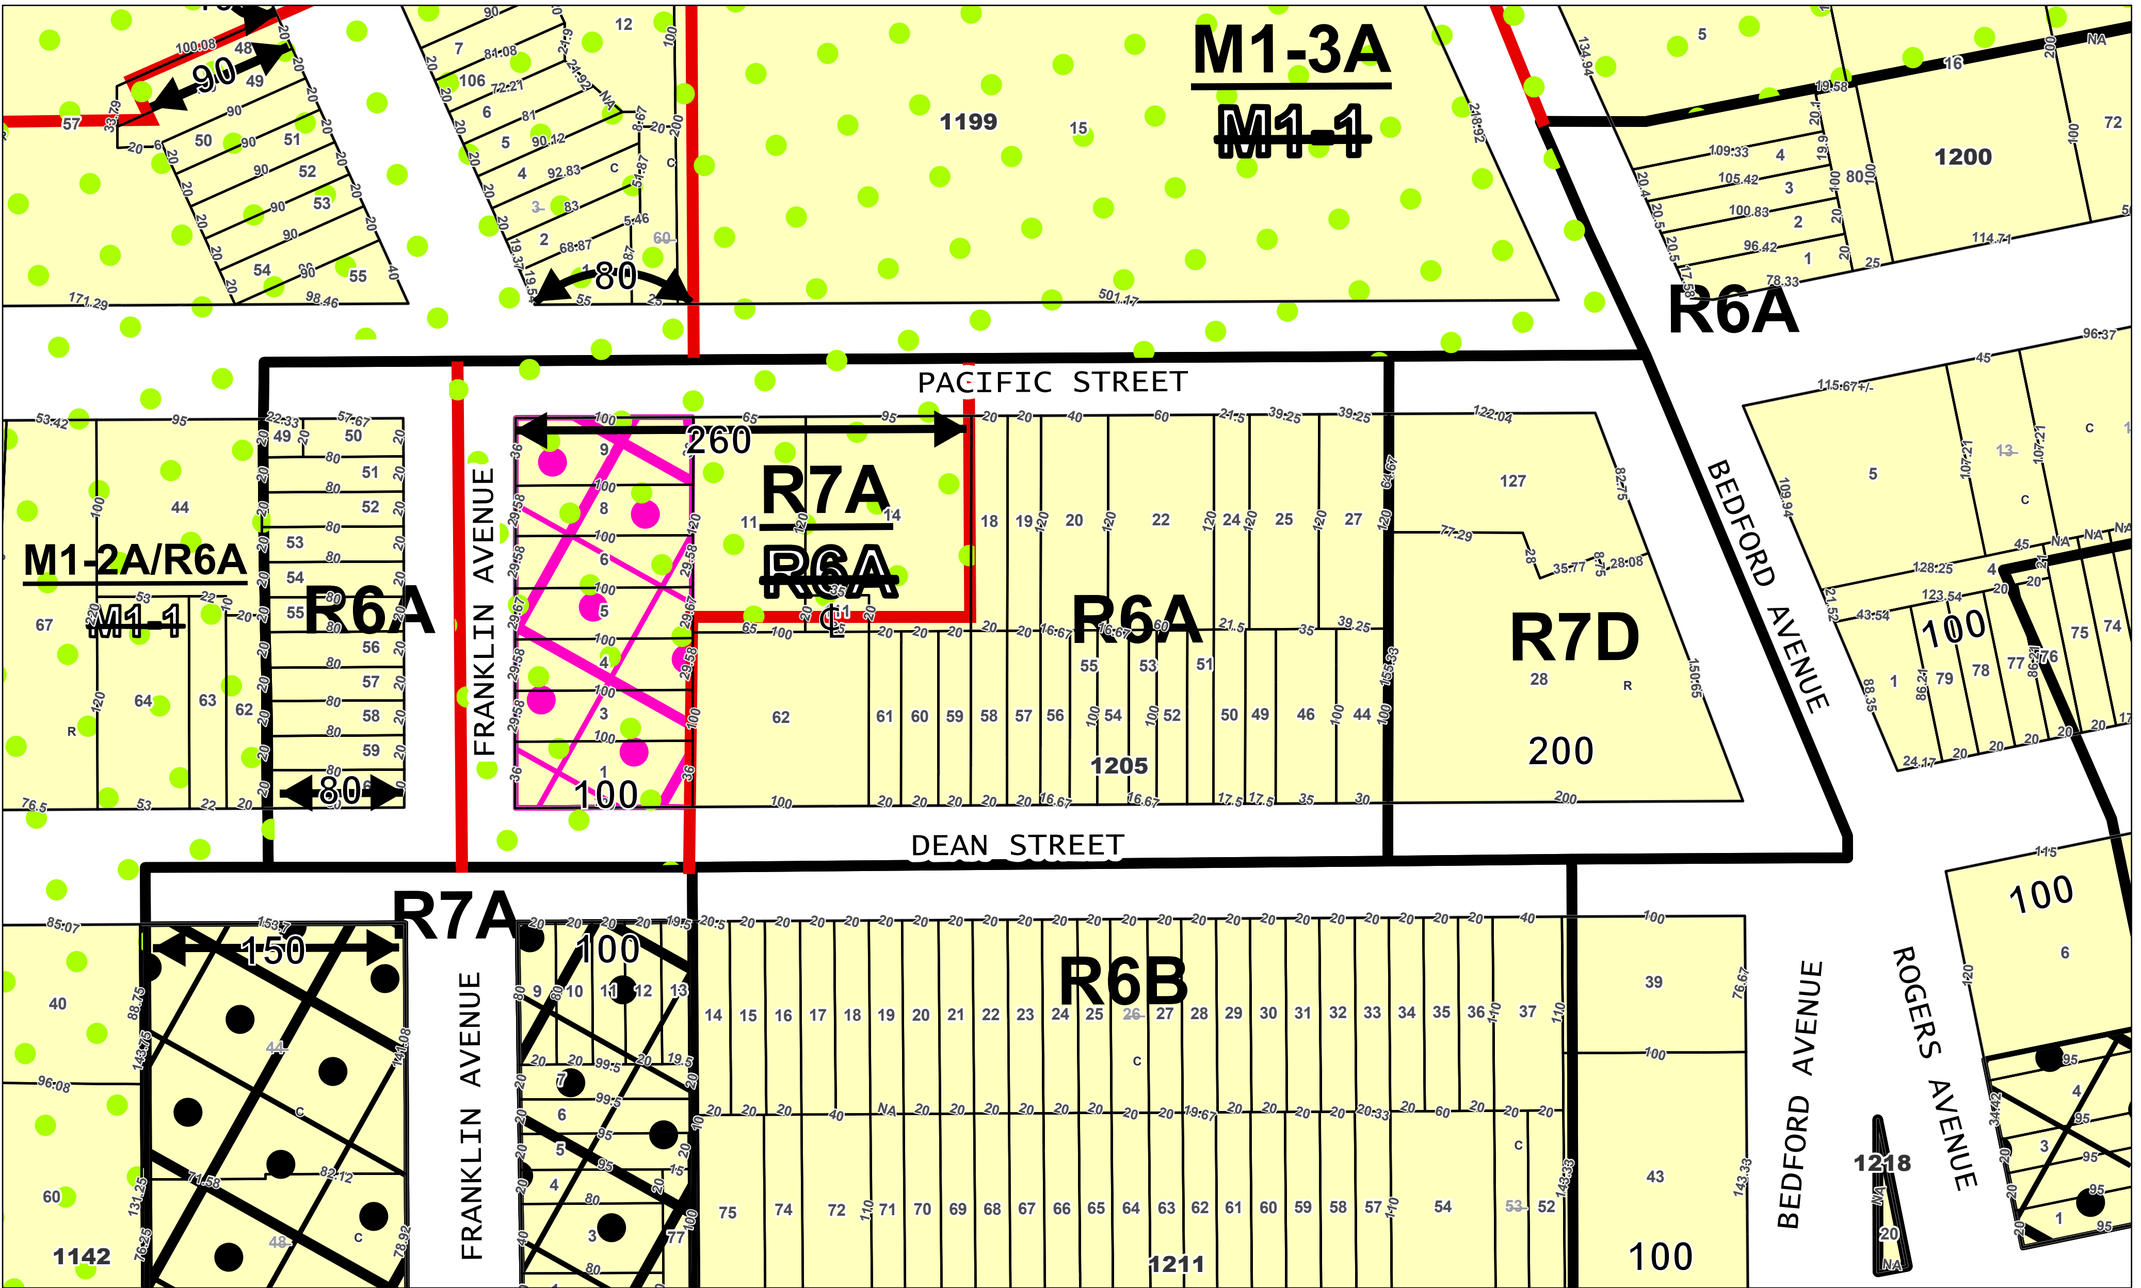

Atlantic Avenue Mixed Use Plan Map 11

Blocks: 1205

Legend

- R8A — Existing Zoning Line/District
- ~~R8A~~ — Eliminated Zoning Line/District
- R8A — Proposed Zoning Line/District
- AAMUP Special District
- MX-20 Removed
- C2-4 Added
- C2-4 Removed
- C1-4 No Change
- C2-3 No Change
- C2-4 No Change
- C2-5 No Change
- 6 — Tax Lot
- 2001 — Tax Block
- 1 — Possession Hooks
- Boundary Line


Note:
A tax lot with a condominium is displayed with the base lot number crossed out along with the letter "C". If the lot has Air Rights or Subterranean Rights it will be displayed with letter "A" or "S" respectively.

Data Date: 3/13/2024
Scale: 1:900

Data Source: DOF Digital Tax Map, NYCMAP 2024
Disclaimer:
This geographic information shown on this map should be used for reference. For official tax maps please contact Dept of Finance.

N

0 20 40 80 120 160 Feet

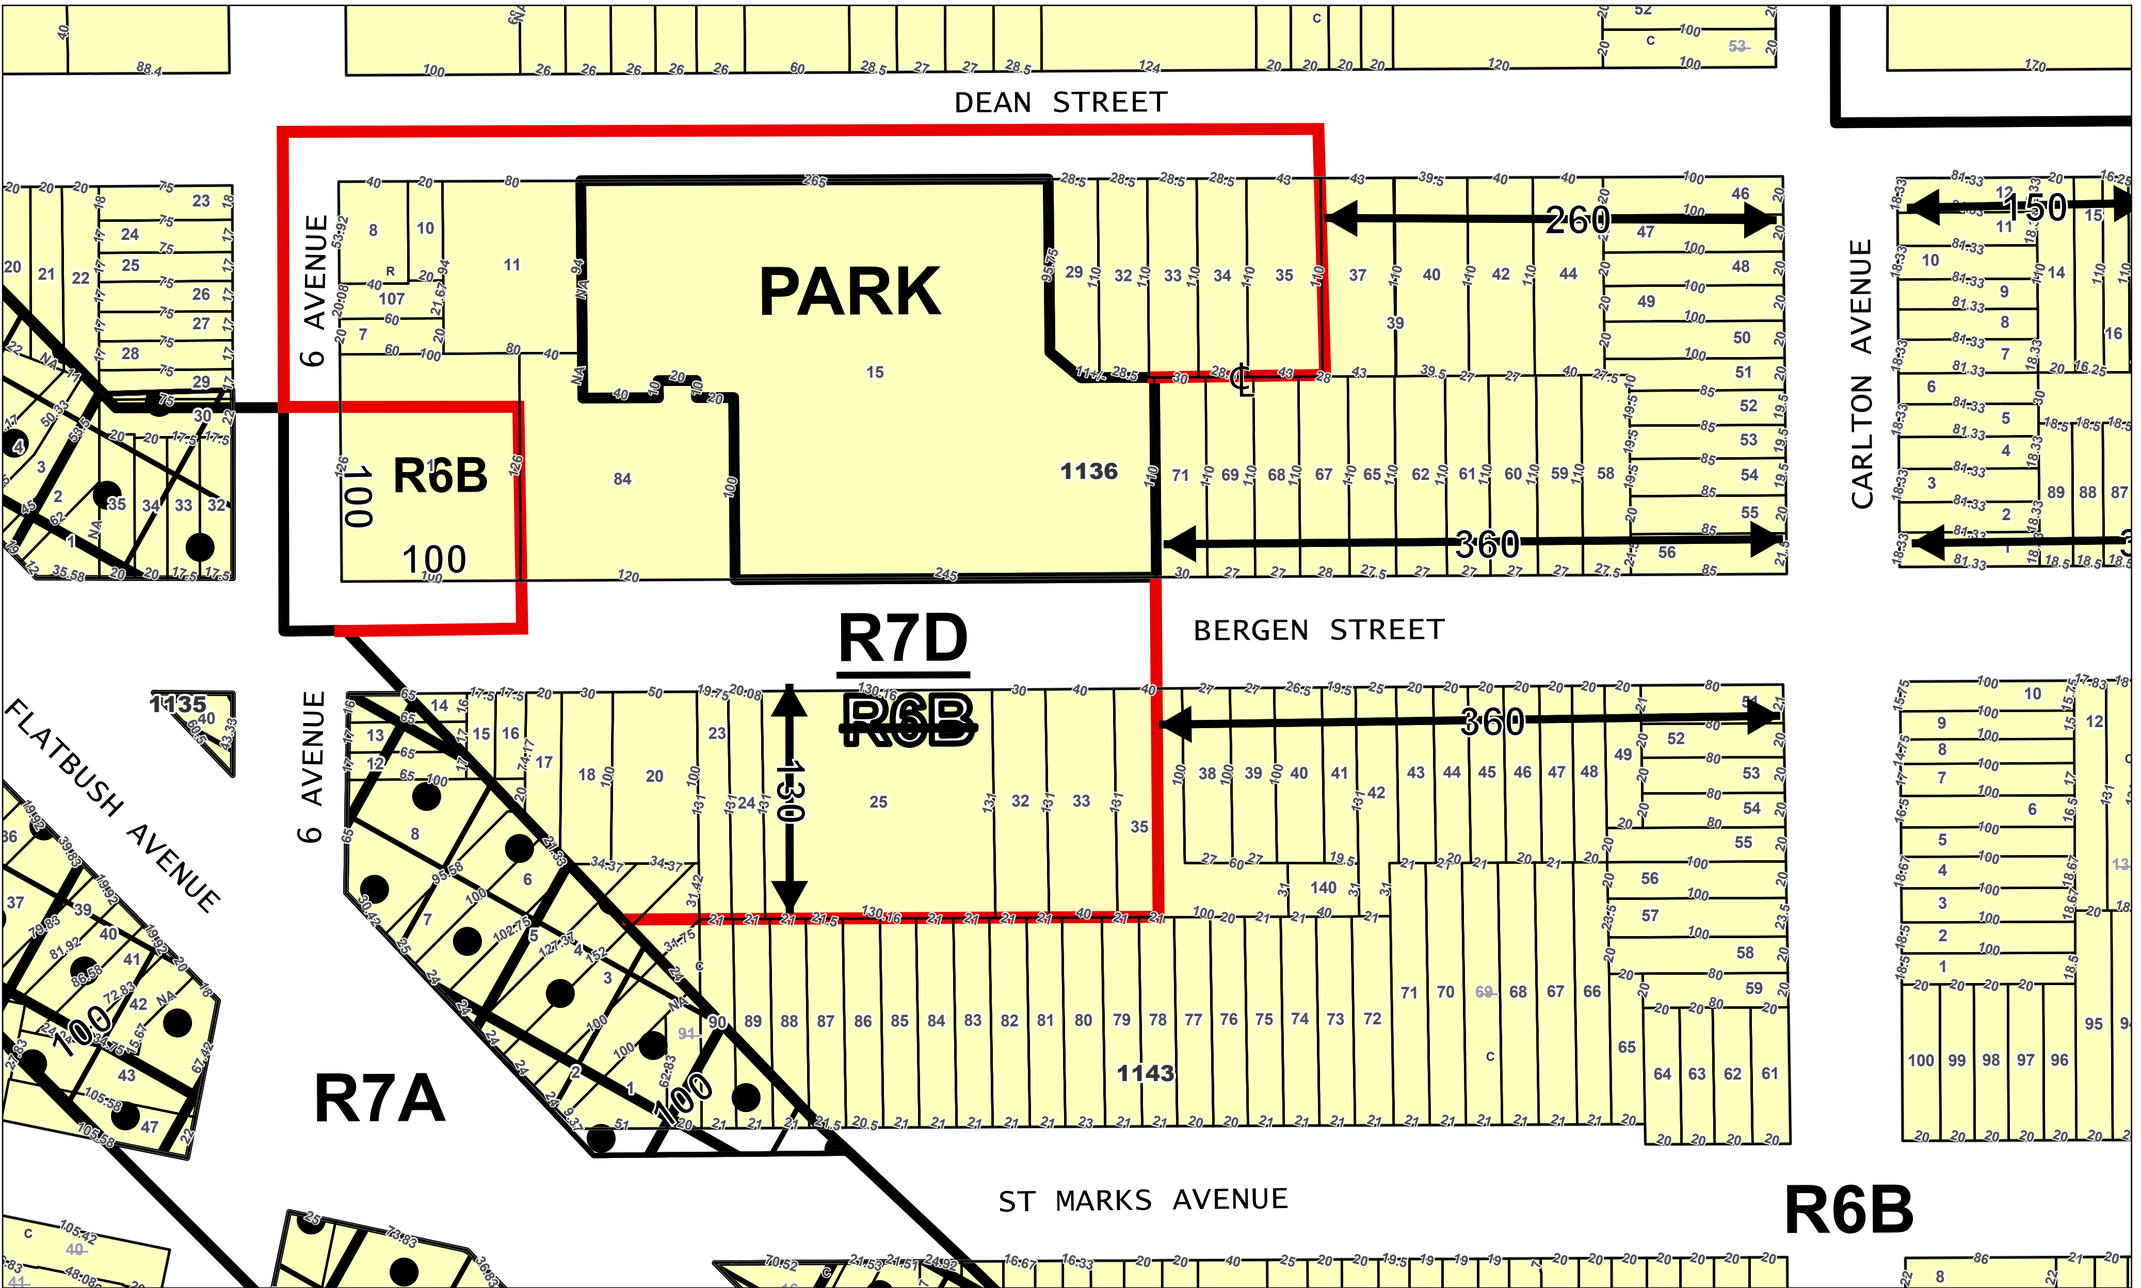

Atlantic Avenue Mixed Use Plan Map 12

Blocks: 1136 & 1143

Legend

- R8A — Existing Zoning Line/District
- R8A — Eliminated Zoning Line/District
- R8A — Proposed Zoning Line/District
- AAMUP Special District
- MX-20 Removed
- C2-4 Added
- C2-4 Removed
- C1-4 No Change
- C2-3 No Change
- C2-4 No Change
- C2-5 No Change
- 6 — Tax Lot
- 2001 — Tax Block
- 1 — Possession Hooks
- Boundary Line

Note:
A tax lot with a condominium is displayed with the base lot number crossed out along with the letter "C". If the lot has Air Rights or Subterranean Rights it will be displayed with letter "A" or "S" respectively.

Data Date: 3/13/2024
Scale: 1:900

Data Source: DOF Digital Tax Map, NYCMAP 2024
Disclaimer:
This geographic information shown on this map should be used for reference. For official tax maps please contact Dept of Finance.

N

0 20 40 80 120 160 Feet